

Rice County


FORM 51 5M BR1X

KANSAS

Section 26 Township 19 Range 9W

Well No. 1 Seely "B"

Company Bishop Oil

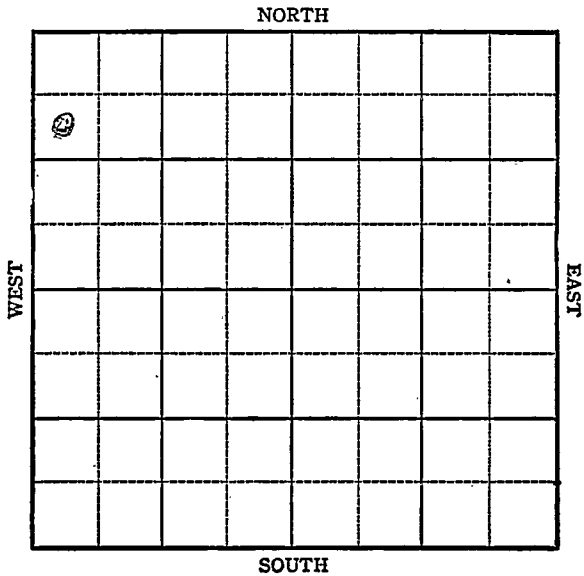

KANSAS

Rice

Sec. 26 Twp. 19 R. 9W


Well No. #1 Seely "B" Farm
Bishop Oil Company

Chase
990' Ft. from N. Line

Ft. from S. Line

Ft. from E. Line

330' Ft. from W. Line

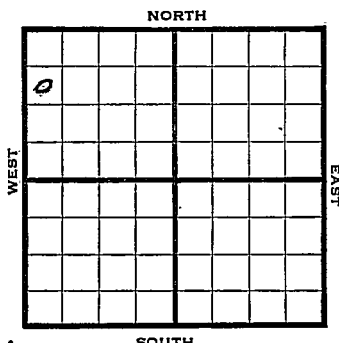

Elev. 1717

1944

REPORT

6/28	167 running casing
7/12	Lans 2886 Arb 3272 TD 3277 5" @ 3272 RUST
7/19	500 acid Swb 4 fluid per hr 35% oil
7/26	Arb 3272 5" @ 3272 500 Acid Pump 35 oil Pot. Grav. 42. TD 3277

COMPLETED

KANSAS

Pool Name ChaseMap No. 49 Sec. 26 Twp. 19 R. 9WWell No. 1 Seely "B"Bishop Oil

Company

COMPLETED

Contractor

SW NW NW

SECTION PLAT

0			

990 Ft. from N. Line Ft. from S. Line Ft. from E. Line330 Ft. from W. LineRice CountyLocation Rig up

Drilling and Remarks:


RECORD

Cased in.; ft.Sand Gas Oil Total Depth 3277

PRODUCTION

1st 24 hrs. Nat. 1st 24 hrs. after shot Gas Cu. Ft.Dry Hole Abandoned

Date

JUL 26 1944

19

S. J. LEWIS

Scout

KANSASPool Name ChaseMap No. 49 Sec. 26 Twp. 19 R. 9WWell No. 1 Seely "B"Bishop Oil

Company

FIRST REPORT

Contractor

SW NW NW**SECTION FLAT**990

Ft. from N. Line

Ft. from S. Line

Ft. from E. Line

330

Ft. from W. Line

o			

Rice County

Location _____

Rig up _____

Drilling and Remarks:

167 run csg.**RECORD**

Cased _____ in., _____ ft.

Sand _____

Gas _____

Oil _____

Total Depth _____

PRODUCTION

1st 24 hrs. Nat. _____

1st 24 hrs. after shot _____

Gas _____ Cu. Ft.

Dry Hole _____

Abandoned _____

Date

JUN 28 194419S. J. LEWIS

Scout