


Section 26 Township 19 Range 2 W

Well No. #3 Williams

Company K & P Oil

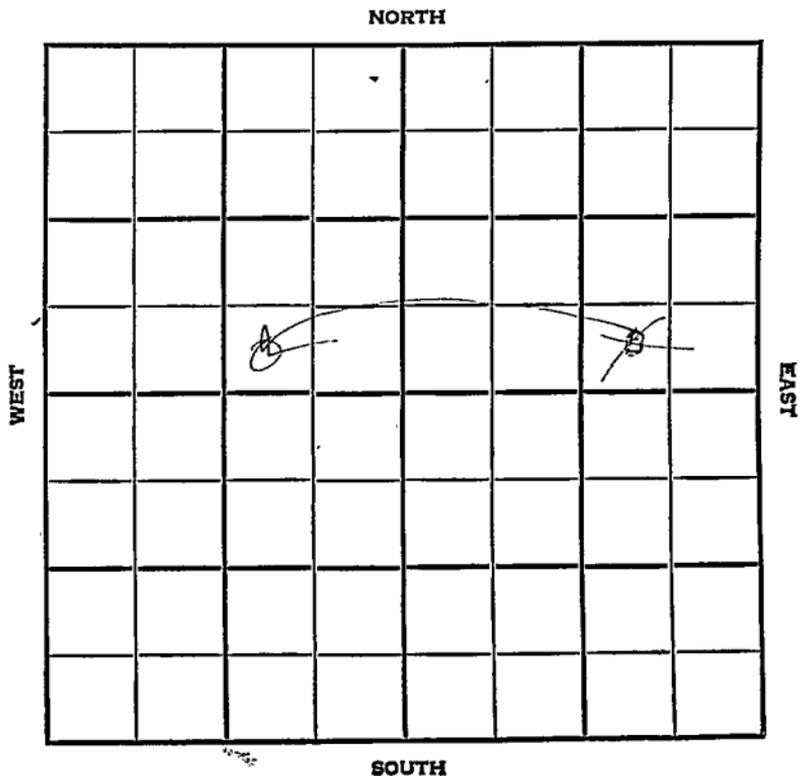

SEC. 26	TWP. 19	R. 2W
------------	------------	----------

WELL NO.

#3 Williams

FARM

COMPANY

K & P Oil

CONTRACTOR

Mallard

Ritz-Canton

Ft. from N. Line

430

Ft. from S. Line


Ft. from E. Line

1658

Ft. from W. Line

SW SE NE

NW

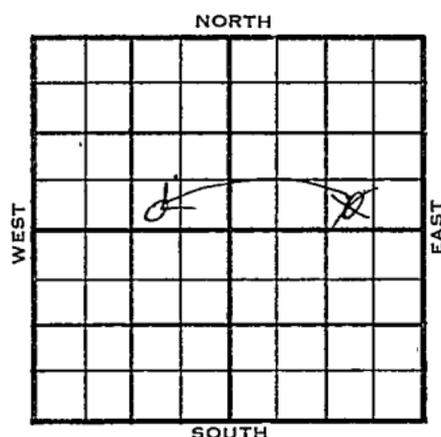

1956

ELEVATION

1545

REPORT

3-14

Location

5-2

Comm. 3-14-56

8 5/8" @ 161 w/90

5 1/2" @ 2940

CO DD 2958, 1000 A

PB 2938, 192/ 2912-36

CO to 2958

FU 765' fluid

Comp. 10 bopd, 100 bw

M. 2908

TD 2943'

COMPLETED

County McPherson Elev. _____
 Sec. 26 Twp. 19 Rge. 2W
 Company K & R Oil
 Farm Name Williams No. 3

TOPS	DEPTH	LOG	DATUM
Anh.			
Tp.			
H.			
Tr.			
Dg.			
Bl.			
L.			
K.C.			
B.K.C.			
Ce.			
C.			
M.			
M.			
K.			
Mz.			
Mo.			
V.			
S.			
S.			
A.			
R.			
Pe.			
G.			
T.P.			

Loc. in Sec. _____
SW SE, NE
430' SL
1658' WL
 Geol. _____
 Contr. _____
Hallard
 Pool _____
Fitz-Canton

FIRST REPORT
 MAR 1 1956

Date Comm. MAR 1 4 1956

Location _____

Co.
 Lse.
 No.
 Sec.
 T.
 R.

CORRECTION

FORM 513 REV. SUNRAY

County McPherson Elev. _____
 Sec. 26 Twp. 19 Rge. 2W
 Company K & R Oil
 Farm Name Williams No. 3

TOPS	DEPTH	LOG	DATUM	Loc. in Sec.
Anh.				SW SE NW
TP.				
H.				
Tr.				
Dg.				
Bl.				
L.				
K.C.				Geol. _____
B.K.C.				Contr. _____
Ce.				
C.				Mallard
M.				
M.				Pool
K.				
Mz.				
Me.				
V.				
S.				
S.				
A.				
R.				
PE.				
G.				
T.D.				

CORRECTION

	o	

Date Comm. Reported SWSENE

MAY 2 1956

Co.
Lse.
No.
Sec.
T.
R.

County	McPherson	Elev.	1545
Sec.	26	Twp.	19
Company	K & P Oil		
Farm Name	Williams	No.	3

TOPS	DEPTH	LOG	DATUM	Loc. in Sec.
Anh.				SWSE NW
TP.				430' SL
H.				1658' WL
Tr.				
Dg.				
Bl.				
L.				Geol.
K.C.				Contr.
B.K.C.				Mallard
Ce.				Pool
C.				Ritz-Canton
M.	2908		1363	
M.				
K.				
Mz.				
Mq.				
V.				
S.				
S.				
A.				
R.				
PE.				COMPLETE
G.				
TD.	2943			

Date Comm. 3-14-56 MAY 2 1956

8 5/8" @ 161/90 5 1/2" @ 2940 CO

DD 2958 1000 A PB 2938 192/ 2912-36

CO to 2958 FU 765' fluid

Comp. 10 bopd 100 bw