

KANSAS

Sec. 26 Twp. 19 R. 2W


Well No. #1 Williams Farm

Bradley & Tickel

Company

Ritz-Canton Pool

NORTH

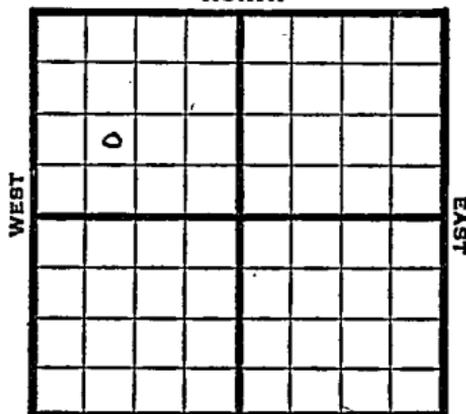

Ft. from N. Line

990' Ft. from S. Line

Ft. from E. Line

990' Ft. from W. Line

.NE SW NW

SOUTH

1948 Elev. 1555' REPORT

8/18 8" @ 153'
Drig. 2034'
8/25 Mississippi 2922-30'
TD 2930'
5" @ 2930'
9/1 TD 2969'
1000 acid
9/8 "
9/14 "
9/21 "
9/29 "
10/6 "
10/13 Miss 2922'
5" @ 2930'
1000 acid
Pump 15 oil pot.
Gr. 390
TD 2968'

COMPLETED

McPherson County Kansas State

Map No. _____ Sec. 26 Twp. 19 R. 2W

Well No. 1 Williams

Bradley & Tickel Company

FIRST REPORT Contractor

NE SW NW

SECTION PLAT

_____ Ft. from N. Line

990 Ft. from S. Line

_____ Ft. from E. Line

990 Ft. from W. Line

Ritz-Canton Pool

Remarks:

8" @ 153 drlg. 2034

Date

AUG 1 8 1948

Scout

S. J. LEWIS

