


Map No. KANSAS Sec. 26 Twp. 19 R. 2^w
Well No. 1-Williams Farm
Dickey & Shell Company

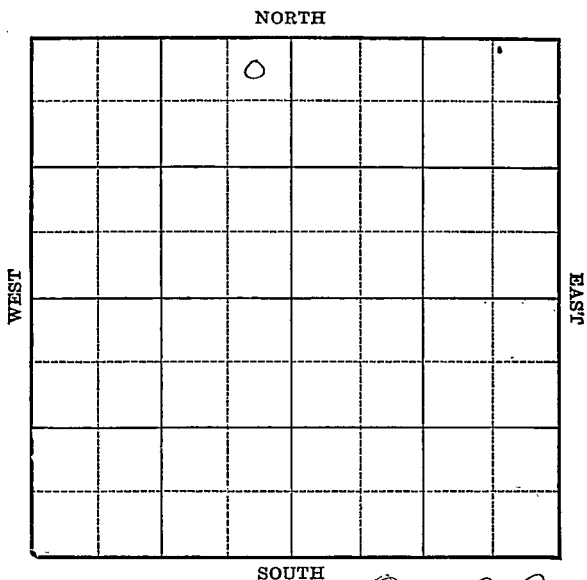

Location _____
Drilling Remarks _____

Rig Up _____
Drilling Remarks _____

RECORD

Cased _____ in. _____ ft.
Sand _____
Gas _____
Oil _____
Total Depth _____

PRODUCTION

1st 24 hrs. Nat. _____
1st 24 hrs. after shot _____
Gas _____ cu. ft.
Dry Hole _____
Abandoned _____

Map No. KANSAS Sec. 26 Twp. 19 R. 2^w

Well No. 1-Williams Farm
Dickey & Shell Company


330 Ft. from N. Line

 Ft. from S. Line

330 Ft. from E. Line

 Ft. from W. Line

1931

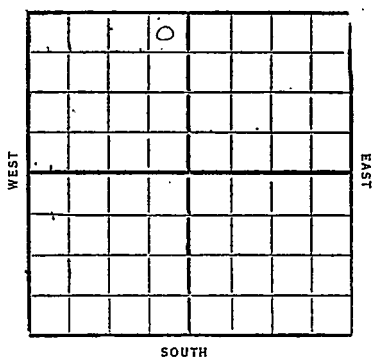

Date	REPORT
2/4	ROS.
2/11	Rgn. up
2/18	Spud 105'
2/25	Drilg 860
3/4	" 1630'
3/11	" 2305'
3/18	TD. 2430 UIR 8"
3/25	Top Chat 2895
4/1	Drilg 2902 sho gas
4/1	3 rd gas 2937-39
4/8	& est 50 bbl oil an hr
4/8	Chat 2895-2948
	Oil 2937-48
	TD. 2948
	400 bbls oil
	3 rd gas
	Comp.
1933	QWHD.
5/10	Old TD. 2948' Sign deep to Deepen
5/17	Drilg 3117'
5/24	Pulling 5" 326'
6/1	Base line 3134 Drilg 3235

1933

6/8 Cement 5" 3315 Top Viola 3370'

6/15 Top 3373 Correction Running 4" liner

6/21 T.D. 3379' flow 6 bbls per hr Nat
treated 1000 gal acid pumped
248 bbls 16 hr 2% D.S.

6/28 —

7/12 - Top Viola 3373

T.D. 3379

360 bbls

Cutting 17% water

COMPLETED

*W. J. Person*Map No. **KANSAS** Sec. 26 Twp. 19 R. 2WWell No. 43 *Williams**Tickey & Shell* Company*J* Contractor


SECTION PLAT

330 Ft. from N. Line

..... Ft. from S. Line

330 Ft. from E. Line

..... Ft. from W. Line

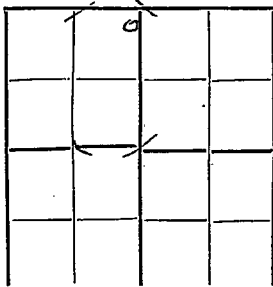

FIRST REPORTS

Location.....

Rig up.....

Drilling and Remarks:

R.D.G.

RECORD

Cased.....in.,ft.

Sand.....

Gas.....

Oil.....

Total Depth.....

PRODUCTION

1st 24 hrs. Nat.....

1st 24 hrs. after shot.....

Gas.....Cu. Ft.

Dry Hole.....

Abandoned.....

Date

FEB 4 1931S. J. FWIS Scout

[Handwritten signature]

Returned	
Cards	<i>[Handwritten signature]</i>
Tracing	<i>[Handwritten signature]</i>
France Map	X
Scarborough Map	<i>[Handwritten signature]</i>
Moody Map	X
Scarborough Plat Book	
Moody Plat Book	

McPherson

43 KANSAS Sec. 26 Twp. 19 R. 2 W

Well No. 1 Williams

Dickey & Sheel Company

Contractor

COMPLETE

330 Ft. from N. Line

Ft. from S. Line

330 Ft. from E. Line

Ft. from W. Line

SECTION PLAT

Location

Rig up

Drilling and Remarks:

Oil 2937-48'

400 lbs Oil

3 M Gas

RECORD

Cased in, ft.

Sand 2895-2948

Gas

Oil

Total Depth 2948

PRODUCTION

1st 24 hrs. Nat.

1st 24 hrs. after shot

Gas Cu. Ft.

Dry Hole

Abandoned

Date

APR 8 1931

192

CHAS. L. SHERWOOD

Scout

Received
Warrant

Returned	<i>[Signature]</i>
Cards	<i>[Signature]</i>
Tracing	<i>[Signature]</i>
France Map	<i>[Signature]</i>
Scarborough Map	<i>[Signature]</i>
Moody Map	<i>[Signature]</i>
Scarborough Plat Book	<i>[Signature]</i>
Moody Plat Book	<i>[Signature]</i>

McPherson

43 KANSAS Map No. Sec. 34 Twp. 19 R. 2

Well No. 1 Williams
Geo Dickey & Shew Company

Contractor

SECTION PLAT

		0	
"	DM	"	

330 FIRST REPORTS
Ft. from N. Line

Ft. from S. Line

330 Ft. from E. Line

Ft. from W. Line

Location

Rig up

Drilling and Remarks: old

Rigging up
to deepen

RECORD

Cased in ft.
 Sand May 2895-2948
 Gas
 Oil
 Total Depth 2948

PRODUCTION

1st 24 hrs. Nat.
 1st 24 hrs. after shot
 Gas Cu. Ft.
 Dry Hole
 Abandoned

Date

MAY 10 1933 192 CHAS. L. SHERWOOD Scout




Returned	
Cards	<i>WMB</i>
Tracing	<i>WMB</i>
France Map	<i>X</i>
Scarborough Map	<i>X</i>
Moody Map	<i>X</i>
Scarborough Plat Book	
Moody Plat Book	

McPherson
 Map No. _____ Sec. *26* Twp. *19* R. *2W*
43
 Well No. *1-Williams*
Geobickey & Shell Company
 Contractor

SECTION PLAT

330 Ft. from N. Line
 _____ Ft. from S. Line
330 Ft. from E. Line
 _____ Ft. from W. Line

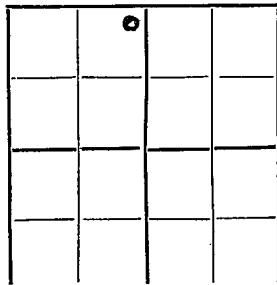**COMPLETED**

Location _____

Rig up _____

Drilling and Remarks:

*Viola 3373**360 bbls**17% water***RECORD**

Cased _____ in., _____ ft.

Sand _____

Gas _____

Oil _____

Total Depth *3379***PRODUCTION**

1st 24 hrs. Nat. _____

1st 24 hrs. after shot _____

Gas _____ Cu. Ft.

Dry Hole _____

Abandoned _____

Date

7/12/33 192 *Orval Mennschick* *Scott*

Returned

Cards

Tracing

France Map

Scarborough Map

Moody Map

Scarborough Plat Book

Moody Plat Book