

McPherson


Form 51-5M-2-29-34703

Map No. **KANSAS** Sec. 26 Twp. 19 R. 2W

Well No. 2-Williams Farm

Dickey Oil Company

NORTH

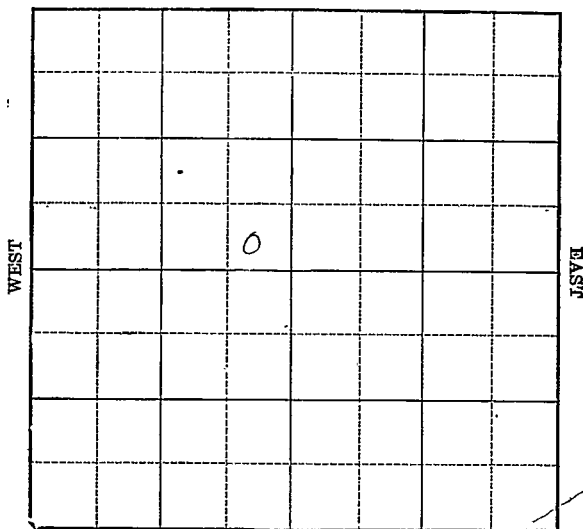

SOUTH

OW 25

Location

Drilling Remarks

Rig Up

Drilling Remarks

RECORD

Cased _____ in. _____ ft.

Sand _____

Gas _____

Oil _____

Total Depth _____

PRODUCTION

1st 24 hrs. Nat. _____

1st 24 hrs. after shot _____

Gas _____ cu. ft.

Dry Hole _____

Abandoned _____


Map No. **KANSAS** Sec. 26 Twp. 19 R. 2^W
Well No. 2-Williams Farm
Duckey Oil Company
Sheet

 Ft. from N. Line

330 Ft. from S. Line

330 Ft. from E. Line

1931 Ft. from W. Line

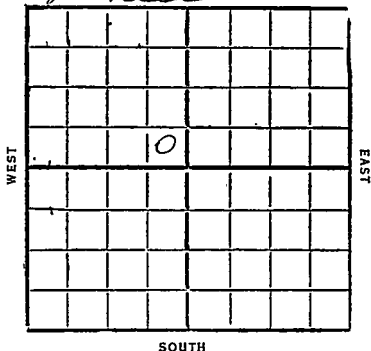

Date	REPORT
12/19	Log
12/16	Pros.
12/22	Blkg rug
12/30	
1932	
1/7	Plan up
1/13	Spdg.
1/20	515 250'
1/27	
2/3	Dreg 325'
2/10	" 1220'
2/17	" 2010'
2/26	T.D. 2400' V/R 8"
3/2	8"-2461
	Dreg 2610'
3/9	Chat 2890-2925
	Est 5 Mc gas
	V/R 6" Casg
3/16	Cased 6"-2912
	Chat 2894-2960
	T.D. 2960
	Est 500 bbl oil & 6 Mc gas
	Comp.

1933

O.W.D.D.

3319

6/21- Drilling Deeper

6/28 " 3290'

7/5 " 3305'

7/12

7/19- Top Viola 3372

T. D. 3395

200 bbls

COMPLETED

McPherson

Map No. **KANSAS** Sec. **26** Twp. **19** R. **2** ^W
 Well No. **43** **2** **Williams**
Dickey Oil Co Company

Contractor

FIRST REPORTS

Ft. from N. Line

330 Ft. from S. Line**330** Ft. from E. Line

Ft. from W. Line

SECTION PLAT

	0		

Location ☒

Rig up

Drilling and Remarks:

RECORD

Cased.....in.,ft.

Sand.....

Gas.....

Oil.....

Total Depth.....

PRODUCTION

1st 24 hrs. Nat.....

1st 24 hrs. after shot.....

Gas.....Cu. Ft.

Dry Hole.....

Abandoned.....

Date

DEC 9 1931 CHAS. L. SHERWOOD
 192.....Scout

Returned _____

Cards _____

Tracing *CRK* _____

France Map _____

Scarborough Map _____

Moody Map _____

Scarborough Plat Book _____

Moody Plat Book _____

McPherson

43

Map No. KANSAS Sec. 26 Twp. 19 R. 2 ^WWell No. 2 WilliamsDickey Oil Co

Company

Contractor

COMPLETE

 Ft. from N. Line330 Ft. from S. Line330 Ft. from E. Line Ft. from W. Line

SECTION PLAT

	0		

Location Rig up

Drilling and Remarks:

621 500 Bbs.

RECORD

Cased 6 in., 2912 ft.Sand May 2894-2960Gas Oil Total Depth 2960

PRODUCTION

1st 24 hrs. Nat. 1st 24 hrs. after shot Gas 6 MA Cu. Ft.Dry Hole Abandoned

Date

MAR 1 6 1932 19 CHAS. L. CHIERWOOD

Scout

Returned *JP*
Cards *CS*
Tracing *CS*
France Map *CS*
Scarborough Map *CS*
Moody Map *CS*
Scarborough Flat Book *CS*
Moody Flat Book *CS*

McPherson
 Map No. *43* Sec. *26* Twp. *19* R. *2 W*

Well No. *2 Williams*

Dickey & Shell Company

Contractor

SE NW

SECTION PLAT

FIRST REPORTS

Ft. from N. Line

Ft. from S. Line

Ft. from E. Line

Ft. from W. Line

Location

Rig up

Drilling and Remarks:

2960 O.T. H.

RECORD

Cased in, ft.

Sand

Gas

Oil

Total Depth

PRODUCTION

1st 24 hrs. Nat.

1st 24 hrs. after shot

Gas Cu. Ft.

Dry Hole

Abandoned

Date

6/21/33 192 *Paul M. Munschick* out

Journal

Returned	
Cards	<i>MB</i>
Tracing	<i>MB</i>
France Map	<i>X MB</i>
Scarborough Map	<i>X MB</i>
Moody Map	<i>X MB</i>
Scarborough Plat Book	<i>X MB</i>
Moody Plat Book	<i>X MB</i>

Map No. 43 Sec. 26 Twp. 19 R. 2WWell No. 2 - WilliamsDickey & Shell Company

Contractor

SECTION PLAT

	0		

Ft. from N. Line

330 Ft. from S. Line330 Ft. from E. Line

Ft. from W. Line

COMPLETED

Location

Rig up

Drilling and Remarks:

Top viola
3372200 bbls

RECORD

Cased.....in.,ft.

Sand.....

Gas.....

Oil.....

Total Depth 3395

PRODUCTION

1st 24 hrs. Nat.....

1st 24 hrs. after shot.....

Gas.....Cu. Ft.

Dry Hole.....

Abandoned.....

Date

7/19/33 192Orval Mennich Scout

Returned _____
Cards *MB* _____
Tracing *MB* _____
France Map *MB* _____
Scarborough Map *MB* _____
Moody Map *MB* _____
Scarborough Plat Book _____
Moody Plat Book _____