


MCPHERSON KANSAS

Section 26 Township 19 Range 2W

Well Number 1 Lewis


Company Hutchinson O & G

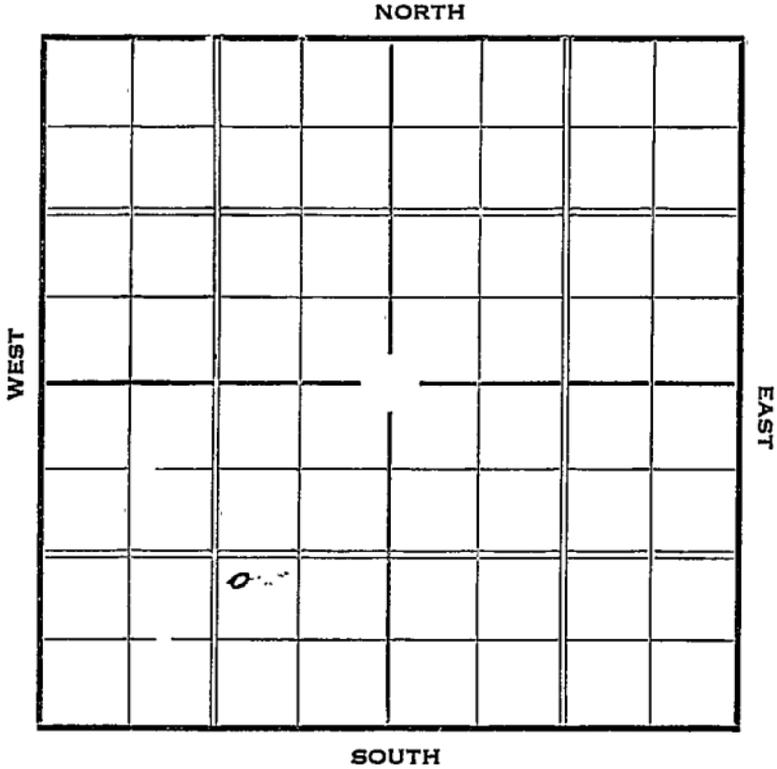

Sec. 26 Twp. 19 R. 2-W

Well No. #1 Lewis Farm
Hutchinson O & G Company

_____ Ft. from N. Line
990 Ft. from S. Line
990 Ft. from E. Line
 _____ Ft. from W. Line
 Elev. 1547

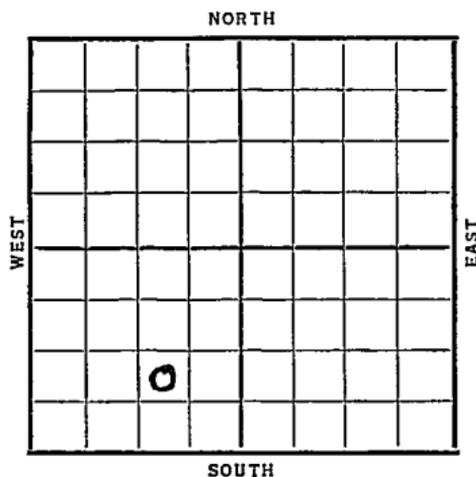

Date	REPORT
1937	
1/13	Shut down 2440'.
1/21	Drlg. 2550'.
1/28	Shut down 2550'.
2/4	" " "
2/11	" " "
2/18	6" @ 2450'. Chat 2923'.
	TD 2970' hole full oil.
2/26	" " " "
3/4	Shut Down.
3/10	Chat 2923'.
	T. D. 2970'.
	Potential 80 oil 20% water.
	COMPLETED

Map No. 43 Sec. 26 Twp. 19 R. 2W

Well No. 1 Lewis

Hutchinson Oil Co. Company

Contractor

SECTION PLAT

	0		

_____ Ft. from N. Line

990 Ft. from S. Line

990 Ft. from E. Line

_____ Ft. from W. Line

FIRST REPORT

Location _____

Rig up _____

Drilling and Remarks:

2440 (S)

RECORD

Cased _____ in., _____ ft.

Sand _____

Gas _____

Oil _____

Total Depth _____

PRODUCTION

1st 24 hrs. Nat. _____

1st 24 hrs. after shot _____

Gas _____ Cu. Ft.

Dry Hole _____

Abandoned _____

Date

JAN 13 1937

19

S. J. LEWIS

Scout

KANSAS

M. P. Pheasant

Map No. 43 Sec. 26 Twp. 19 R. 2W.

Well No. 1 Lewis

Hickinson O & G. Company

Contractor

SECTION PLAT

	0		

_____ Ft. from N. Line

990 Ft. from S. Line

990 Ft. from E. Line

_____ Ft. from W. Line

COMPLETED

Location _____

Rig up _____

Drilling and Remarks:

Okad 2923

*Potential
80 Oil 20%
water.*

RECORD

Cased _____ in., _____ ft.

Sand _____

Gas _____

Oil _____

Total Depth 2970

PRODUCTION

1st 24 hrs. Nat. _____

1st 24 hrs. after shot _____

Gas _____ Cu. Ft.

Dry Hole _____

Abandoned _____

Date

MAR 10 1937

19

S. J. LEWIS

Scout