

McPherson

Form 51-5M-11-31-Palace

Map No. **KANSAS** Sec. 26 Twp. 19 R. 2W

Well No. 1- Lewis Farm

Vernon Oil & Gas Company

NORTH

WEST

EAST

SOUTH

OWNED

Location

Drilling Remarks

Rig Up

Drilling Remarks

RECORD

Cased in. ft.

Sand

Gas

Oil

Total Depth

PRODUCTION

1st 24 hrs. Nat.

1st 24 hrs. after shot


Gas cu. ft.

Dry Hole

Abandoned

Map No. **KANSAS** Sec. 26 Twp. 19 R. 2^w
Well No. 1- Lewis Farm
Vernon O & S Co Company

 Ft. from N. Line
330 Ft. from S. Line
330 Ft. from E. Line
1932 Ft. from W. Line

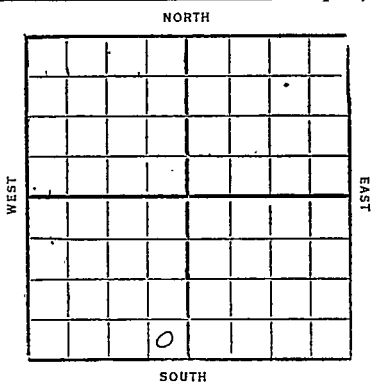

Date	REPORT
3/2	Bldg rug
3/9	—
3/16	Reg
3/22	Drlg 460'
3/30	8 12"-671
4/6	Drlg 1450'
4/13	8 10"-1623
4/20	Drlg 2140'
4/27	HFW 2410-25
5/4	8 14"-2261
5/11	U/R 8 14"-2452
5/18	TD 2452
5/25	Will Cement Cave
6/1	SD 2452
6/8	—
6/15	—
6/22	—

6/29. Cased 6"-2905
Chat 2905-71
Pay 2965-71
TD 2971
flow 225 bbl oil and
125 bbl water 24 hr
 $\frac{1}{2}$ ft gas
Comp.

1932 OWDD
9/30 - Cased TD 2971
UIR 6"-3122'

10/5- Cased 6"-3060
Base line 3130
Top Viola 3366
small show
Cased 5"-3367 SD

10/12- TD 3387
shot 5 and 7 gts
1000' fluid in hole
Well pump.

10/14 —
10/26- TD 3387' No test

11/2- 5"-3367
Viola 3367-87
TD 3387
shot 5 and 7 gt
Pump 110 bbl
Comp

43 KANSAS

Map No. _____ Sec. 26 Twp. 19 R. 2^W

Well No. 1 Lewis

Vernon Oil & Gas Co

Company

Contractor

FIRST REPORTS

SECTION PLAT

_____ Ft. from N. Line

330 Ft. from S. Line

330 Ft. from E. Line

_____ Ft. from W. Line

Location _____

Rig up _____

Drilling and Remarks:

Blow Rig

RECORD

Cased _____ in., _____ ft.

Sand _____

Gas _____

Oil _____

Total Depth _____

PRODUCTION

1st 24 hrs. Nat. _____

1st 24 hrs. after shot _____

Gas _____ Cu. Ft.

Dry Hole _____

Abandoned _____

Date

MAR 2 1932

CHAS. L. SHERWOOD

19

Scout

[Handwritten signature]

Returned	<i>[Signature]</i>
Cards	<i>[Signature]</i>
Tracing	<i>[Signature]</i>
France Map	<i>[Signature]</i>
Scarborough Map	<i>[Signature]</i>
Moody Map	<i>[Signature]</i>
Scarborough Plat Book	
Moody Plat Book	


43 KANSAS Sec. 26 Twp. 19 R. 2^W
 Well No. 1 Lewis

Vernon Oil & Gas Co. Company

Contractor

COMPLETED

SECTION PLAT

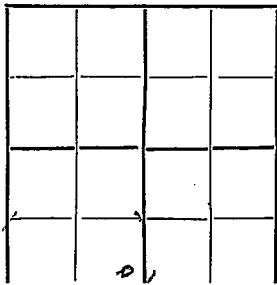

.....Ft. from N. Line

330 Ft. from S. Line

330 Ft. from E. Line

.....Ft. from W. Line

Location.....

Rig up.....

Drilling and Remarks:

Pay 2965-71

Flow 225, Bbls/hr
 & 125 Bbls Water
 in 24 hours.

RECORD

Cased 7/6 in., 2905 ft.

Sand Chas 2905-71

Gas.....

Oil.....

Total Depth: 2971

PRODUCTION

1st 24 hrs. Nat.....

1st 24 hrs. after shot.....

Gas 1 1/2 M Cu. Ft.

Dry Hole.....

Abandoned.....


Date

JUN 29 1932

192

CHAS. L. SHERWOOD

Scout

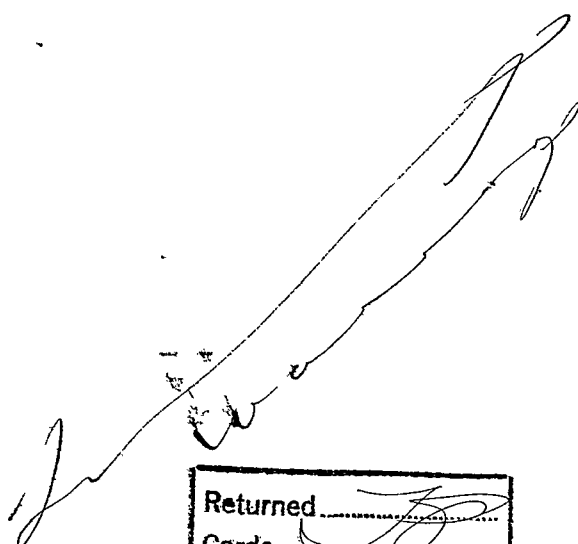

Returned.....	<i>[Signature]</i>
Cards.....	<i>[Signature]</i>
Tracing.....	<i>[Signature]</i>
France Map.....	<i>[Signature]</i>
Scarborough Map.....	<i>[Signature]</i>
Moody Map.....	<i>[Signature]</i>
Scarborough Plat Book.....	<i>[Signature]</i>
Moody Plat Book.....	<i>[Signature]</i>

McPherson

43 KANSAS

Map No. _____ Sec. 26 Twp. 19 R. 2 W

Well No. 1 Lewis

Vernon Oil & Gas Co. Company

Contractor

FIRST REPORTS

_____ Ft. from N. Line

330 Ft. from S. Line

330 Ft. from E. Line

_____ Ft. from W. Line

SECTION PLAT

	11	0	W D

Location _____

Rig up _____

Drilling and Remarks:

old

4 1/2" 31.22

RECORD

Cased _____ in., _____ ft.

Sand Chat 2905-71

Gas _____

Oil _____

Total Depth 2971

PRODUCTION

1st 24 hrs. Nat. _____

1st 24 hrs. after shot _____

Gas _____ Cu. Ft.

Dry Hole _____

Abandoned _____

Date

SEP 30 1932

CHAS. L. SHERWOOD

192

Scout

Returned _____

Cards _____

Tracing _____

France Map _____

Scarborough Map _____

Moody Map _____

Scarborough Plat Book _____

Moody Plat Book _____

43 KANSAS

Map No. _____ Sec. 26 Twp. 19 R. 2

Well No. 1 Lewis

Vernon Oil & Gas Co. Company

Contractor

COMPLETED

_____ Ft. from N. Line

330 Ft. from S. Line

330 Ft. from E. Line

_____ Ft. from W. Line

SECTION PLAT

Location _____

Rig up _____

Drilling and Remarks:

Shot 507 gals.

Pump 110. Bls.

RECORD

Cased 5" in. 3367 ft.

Sand 3367-87

Gas _____

Oil _____

Total Depth 3387

PRODUCTION

1st 24 hrs. Nat. _____

1st 24 hrs. after shot _____

Gas _____ Cu. Ft.

Dry Hole _____

Abandoned _____


Date

NOV 2

1932

CHAS. L. SHERWOOD

Scout

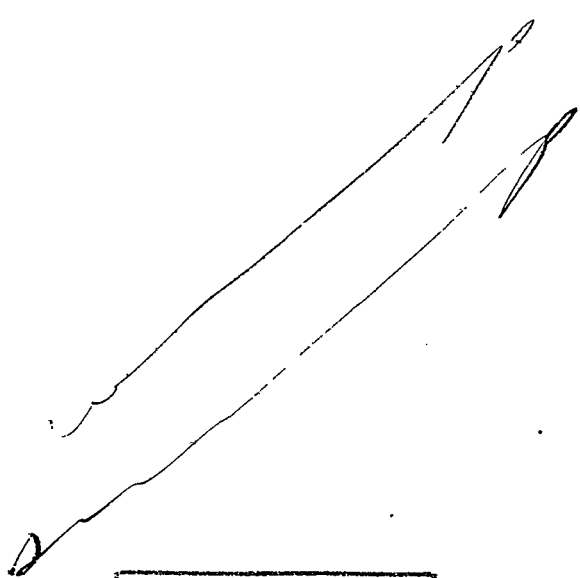

Returned	<i>[Signature]</i>
Cards	<i>[Signature]</i>
Tracing	<i>[Signature]</i>
France Map	<i>[Signature]</i>
Scarborough Map	<i>[Signature]</i>
Moody Map	<i>[Signature]</i>
Scarborough Flat Book	
Moody Flat Book	