


McPherson

Form 51-5M-2-29-34703

Map No. **KANSAS** Sec. 26 Twp. 19 R. 2W

Well No. 1-S/Thomas Farm
Vernon Oil & Gas Company

NORTH

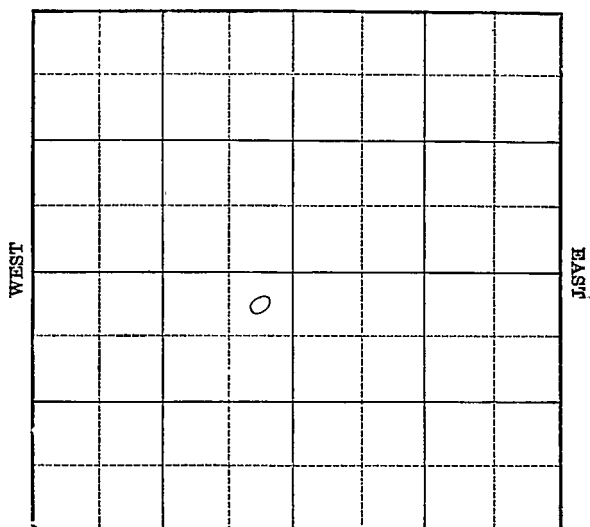

SOUTH

OWDD

Location

Drilling Remarks

Rig Up

Drilling Remarks

RECORD

Cased _____ in. _____ ft.

Sand _____

Gas _____

Oil _____

Total Depth _____

PRODUCTION

1st 24 hrs. Nat. _____

1st 24 hrs. after shot _____

Gas _____ cu. ft.

Dry Hole _____

Abandoned _____

Map No. **KANSAS** Sec. *26* Twp. *19* R. *2*

Well No. 1 120-1115 Farm

Company

NORTH

165 Ft. from N. Line

Ft. from S. Line

300 Ft. from E. Line

Ft. from W. Line

Ft. from W. Line



EAS1

SOUTH

REPORT

10/21 Cellar

10/28	
-------	--

11/4

11/10	—
11/10	—

11/18	Abandon localon
-------	-----------------



FORM 252A-5M-8-30-PETROL

Person Thomas
 Map No. KANSAS Sec. 26 Twp. 19 R. 2^w
 Well No. 1-Thomas Farm
Vernon Oil Company

330 Ft. from N. Line Ft. from S. Line330 Ft. from E. Line Ft. from W. Line

NORTH

WEST

EAST

SOUTH

Date

REPORT

12/2

R.O.S.

12/19

12/16

12/22

12/30

1932

1/6

1/13

1/20

1/27

2/3

2/10

2/17

2/26

3/2

Rig

Run up

Drlg 395'

Drlg 1330'

" 1890'

" 2273'

8"-2273

HF Wat 2405

Drlg 2415'

8"-2459

Drlg 2715'

Chas 2898-2905

Est 2 At Gas

Fishing tools

T.D. 2905'

drlg by tools

T.D. 2905'

Cement Case

3/9. TD. 2905
drlg by tools
3/16 —
3/22 —
3/30 —
4/6- TD. 2905' Trying
to drill by tools 2720
4/13 —
4/20 —
4/27- Cased 6"-2905
Chat. 2905-71
show gas 2907
Pay 2965-71
TD 2971
flow 225 bbl oil
and 125 " water
24 hrs
Comp
1932 OWDD
9/30- Cased TD 2971
4"-3114
drlg 3125'
10/5- Base line 3114
Viola 3364-65
show oil
4" parted
10/12- TD 3377
1000' oil in hole
shot 5 qt
10/19 —
10/26- TD 3377' No test
11/2- T.D. 3377 fsg casing
11/9 —


Map No. Kansas Sec. 26 Twp. 19 R. 2^W
 Well No. 1-Thomas Farm
Vernon Oil Company

330 Ft. from N. Line

 Ft. from S. Line

330 Ft. from E. Line

 Ft. from W. Line

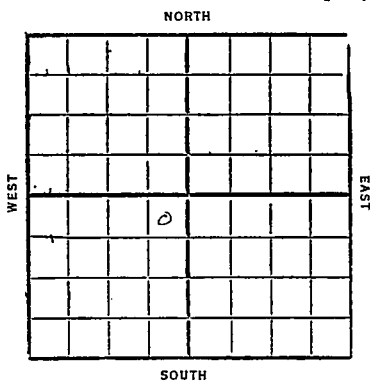

1932

Date	REPORT	OWDD
11/16	TD 3377 fsg csg	
11/23	—	
11/30	—	
12/7	—	
12/14	—	
12/21	—	
12/28	—	
1933		
1/4	—	
1/11	—	
1/18	—	
1/25	—	
2/1	—	
2/8	—	
2/15	—	
2/22	—	
3/4	—	
3/8	Chat 2905-2971'	
	Viola 3364-77' J.D. 3377'	
	Abandoned on acct.	
	fixing job	
	Abandoned	

43 **KANSAS** Sec. 26 Twp. 19 R. 2 ^{vv}

Well No. 1 *Thomas*
Vernon Oil & Gas Co Company

Contractor

FIRST REPORTS

330 Ft. from N. Line

Ft. from S. Line

330 Ft. from E. Line

Ft. from W. Line

SECTION PLAT

	o		

Location

Rig up

Drilling and Remarks:

R.O.S.

RECORD

Cased *7* in. ft.

Sand

Gas

Oil

Total Depth

PRODUCTION

1st 24 hrs. Nat.

1st 24 hrs. after shot

Gas Cu. Ft.

Dry Hole

Abandoned

Date

DEC 2 1931

CHAS. L. SHERWOOD

192

Scout

Answered

Returned	<i>JS</i>
Cards	<i>JS</i>
Tracing	<i>CP</i>
France Map	<i>X</i>
Scarborough Map	<i>X</i>
Moody Map	<i>X</i>
Scarborough Plat Book	<i>X</i>
Moody Plat Book	<i>X</i>

McPherson

43 KANSAS Map No. Sec. 26 Twp. 19 R. 2

Well No. 1 Thomas

Vernon Oil & Gas Co. Company

Contractor

COMPLETED

SECTION PLAT

330 Ft. from N. Line

Ft. from S. Line

330 Ft. from E. Line

Ft. from W. Line

	0		

Location

Rig up

Drilling and Remarks:

Show gas 2907

Pay 2965-71

Flow 225 Bls

125 Bls water

24 Hams.

RECORD

Cased 6 in., 2905 ft.

Sand (Chas) 2905-2971

Gas

Oil

Total Depth 2971

PRODUCTION

1st 24 hrs: Nat.

1st 24 hrs: after shot

Gas Cu. Ft.

Dry Hole

Abandoned

Date

APR 27 1932

CHAS. L. SHERWOOD

192

Scout

Returned _____

Cards _____

Tracing _____

France Map _____

Scarborough Map _____

Moody Map _____

Scarborough Plat Book _____

Moody Plat Book _____

McPherson

43 KANSAS

Map No. _____ Sec. 26 Twp. 19 R. 2 W

Well No. 1 Thomas

Uernow Oil & Gas Co. Company

Contractor

FIRST REPORTS

SECTION PLAT

"	0	W	0	"

330 Ft. from N. Line

_____ Ft. from S. Line

330 Ft. from E. Line

_____ Ft. from W. Line

Location _____

Rig up _____

Drilling and Remarks: _____

RECORD

Cased _____ in., _____ ft.

Sand _____

Gas _____

Oil _____

Total Depth 2971

PRODUCTION

1st 24 hrs. Nat. _____

1st 24 hrs. after shot _____

Gas _____ Cu. Ft.

Dry Hole _____

Abandoned _____


Date

SEP 30 1932

192

CHAS. L. SHERWOOD

Scout

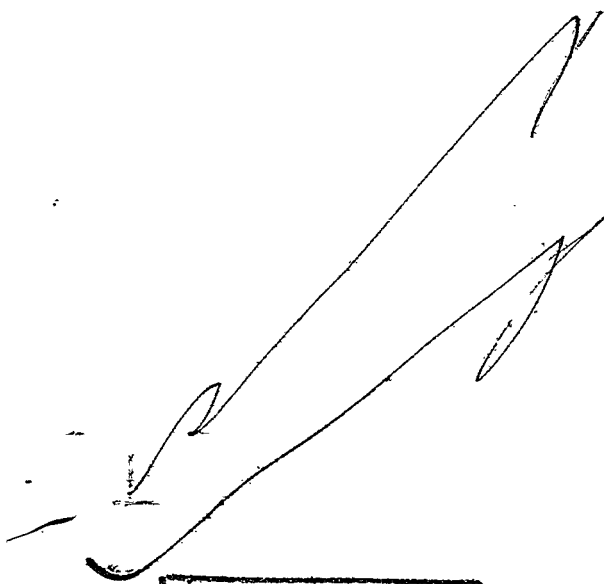

Returned

Cards

Tracing

France Map

Scarborough Map

Moody Map

Scarborough Plat Book

Moody Plat Book

43

KANSAS

Map No. Sec. 26 Twp. 19 R. 2

Well No. 1 Thomas

Vernon Oil & Gas Co. Company

Contractor

COMPLETE

SECTION PLAT

330 Ft. from N. Line

Ft. from S. Line

330 Ft. from E. Line

Ft. from W. Line

	o		

ABANDONED

Location

Rig up

Drilling and Remarks:

Chat 2905-71

Viola 3364-77

ABANDONED Oct

of Fishy Jaw

RECORD

Cased in., ft.

Sand

Gas

Oil

Total Depth 3377

PRODUCTION

1st 24 hrs. Nat.

1st 24 hrs. after shot

Gas Cu. Ft.

Dry Hole

Abandoned ✓

Date

MAR 8 1933

192

CHAS. L. SHERWOOD

Scout

Returned

Cards

Tracing

France Map

Scarborough Map

Moody Map

Scarborough Plat Book

Moody Plat Book

43 *ms phersaw*
 Map No. **KANSAS** Sec. *26* Twp. *19* R. *3* ^W
 Well No. *1* *Thomas*
Vernon Oil & Gas Co Company

Contractor

FIRST REPORTS

SECTION PLAT

165 Ft. from N. Line

Ft. from S. Line

300 Ft. from E. Line

Ft. from W. Line

	0		

Location

Rig up *Cellar*

Drilling and Remarks:

RECORD

Cased _____ in., _____ ft.

Sand _____

Gas _____

Oil _____

Total Depth _____

PRODUCTION

1st 24 hrs. Nat. _____

1st 24 hrs. after shot _____

Gas _____ Cu. Ft.

Dry Hole _____

Abandoned _____

Date

OCT 2 1 1931

CHAS. L. SHERWOOD

192

Scout

[Handwritten signature]

Returned	<i>[initials]</i>
Cards	<i>[initials]</i>
Tracing	<i>[initials]</i>
France Map	<i>[initials]</i>
Scarborough Map	<i>[initials]</i>
Moody Map	<i>[initials]</i>
Scarborough Plat Book	<i>[initials]</i>
Moody Plat Book	<i>[initials]</i>

McPherson
 #3 KANSAS Map No. _____ Sec. *26* Twp. *19* R. *2*^W

Well No. *1 Thomas*

Vernon Oil & Gas Co Company

Contractor

COMPLETED

165 Ft. from N. Line

_____ Ft. from S. Line

300 Ft. from E. Line

_____ Ft. from W. Line

ABANDONED

SECTION PLAT

Location _____

Rig up _____

Drilling and Remarks: _____

RECORD

Cased _____ in., _____ ft.

Sand _____

Gas _____

Oil _____

Total Depth _____

PRODUCTION

1st 24 hrs. Nat. _____

1st 24 hrs. after shot _____

Gas _____ Cu. Ft.

Dry Hole _____

Abandoned *Location*

Date

NOV 18 1931

CHAS. L. SHERWOOD

192

Scout

Handwritten signature or scribble across the top of the page.

Returned	_____
Cards	_____
Tracing	_____
France Map	_____
Scarborough Map	_____
Moody Map	_____
Scarborough Plat Book	_____
Moody Plat Book	_____