


McPherson

Map No. KANSAS Sec. 26 Twp. 19 R. 2 W  
 Well No. 1 "a" Thomas + Gust Farm  
Roland Oil & Gas Co. Company

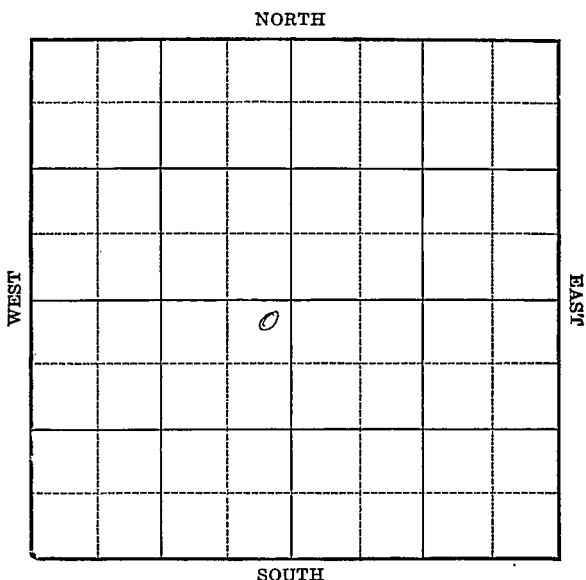

Location \_\_\_\_\_  
 Drilling Remarks \_\_\_\_\_

Rig Up \_\_\_\_\_  
 Drilling Remarks \_\_\_\_\_

**RECORD**

Cased \_\_\_\_\_ in. \_\_\_\_\_ ft.  
 Sand \_\_\_\_\_  
 Gas \_\_\_\_\_  
 Oil \_\_\_\_\_  
 Total Depth \_\_\_\_\_

**PRODUCTION**

1st 24 hrs. Nat. \_\_\_\_\_  
 1st 24 hrs. after shot \_\_\_\_\_  
 Gas \_\_\_\_\_ cu. ft.  
 Dry Hole \_\_\_\_\_  
 Abandoned \_\_\_\_\_

W. O. Rherson


Map No. \_\_\_\_\_ Sec. 26 Twp. 19 R. 2<sup>W</sup>  
Well No. 1 "0" Thomas + Gust Farm  
Roland Oil & Gas Co Company

330' Ft. from N. Line

\_\_\_\_\_ Ft. from S. Line

270' Ft. from E. Line

60' East #1  
\_\_\_\_\_ Ft. from W. Line

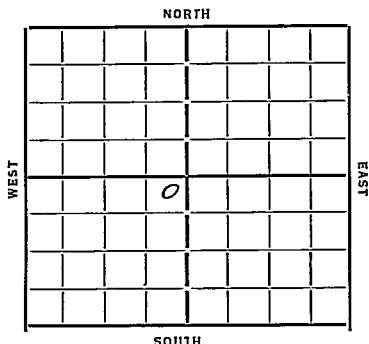

Date 1933

REPORT

4/12 Location  
4/19  
4/26 dly 415'  
5/4 " 1270'  
5/10 S.D. 1600'  
5/17  
5/24  
6/1 10" 1618 bly 1750  
6/8 8" 2222 dly 2285'  
6/15 H.T.W. 2405 8" 2450 dly 2525  
6/21 S.D. 2605'  
6/28 Chat 2898-2925 T.D. 1 1/2 M gas  
7/5 3070 41 R 6"  
7/12 6" 3020 T.D. 3070 Q.O.  
7/19 B.L. 3113' Top Viola 3364 show oil  
3364-65 41 R 5"  
7/26 Cement 5" 3363 T.D. 3379 - 360 oil  
treated 100 gal acid Run tubing  
8/2  
8/9 Viola 3364 T.D. 3379  
300 bbls

COMPLETED

43 KANSAS

Map No. \_\_\_\_\_ Sec. 36 Twp. 19 R. 2

Well No. 1 "a" Thomas &amp; Just

Roland Oil &amp; Gas Co. Company

Contractor

## FIRST REPORTS

330 Ft. from N. Line

\_\_\_\_\_ Ft. from S. Line

270 Ft. from E. Line

\_\_\_\_\_ Ft. from W. Line

## SECTION PLAT

|  |  |  |  |
|--|--|--|--|
|  |  |  |  |
|  |  |  |  |
|  |  |  |  |
|  |  |  |  |
|  |  |  |  |
|  |  |  |  |

Location \_\_\_\_\_ ✓

Rig up \_\_\_\_\_

Drilling and Remarks:

60' East of #1

## RECORD

Cased \_\_\_\_\_ in., \_\_\_\_\_ ft.

Sand \_\_\_\_\_

Gas \_\_\_\_\_

Oil \_\_\_\_\_

Total Depth \_\_\_\_\_

## PRODUCTION

1st 24 hrs. Nat. \_\_\_\_\_

1st 24 hrs. after shot \_\_\_\_\_

Gas \_\_\_\_\_ Cu. Ft.

Dry Hole \_\_\_\_\_

Abandoned \_\_\_\_\_

Date

APR 12 1933

CHAS. L. SHERWOOD

192

Scout

Map No. 43 Sec. 56 Twp. 19 R. 2W  
 Well No. 1A Thomas & Gust  
Roland Oil & Gas Company

Contractor

**COMPLETED**

**SECTION PLAT**

330 Ft. from N. Line

..... Ft. from S. Line

270 Ft. from E. Line

..... Ft. from W. Line

|  |   |  |  |
|--|---|--|--|
|  |   |  |  |
|  |   |  |  |
|  | 0 |  |  |
|  |   |  |  |

Location.....

Rig up.....

Drilling and Remarks:

Viola 3364

**RECORD**

Cased..... in., ..... ft.

Sand.....

Gas.....

Oil.....

Total Depth 3379

**PRODUCTION**

1st 24 hrs. Nat.....

1st 24 hrs. after shot.....

Gas..... Cu. Ft.

Dry Hole.....

Abandoned.....

300 lbs

Date

8/9/33 192 P. Mann Scout