


McPherson
 Form 51-5M-11-31-Palace
 Map No. 26 **KANSAS** Sec. 19 Twp. 22 R. 22
 Well No. 3- Unruks Farm
Derby Oil & Texas Company

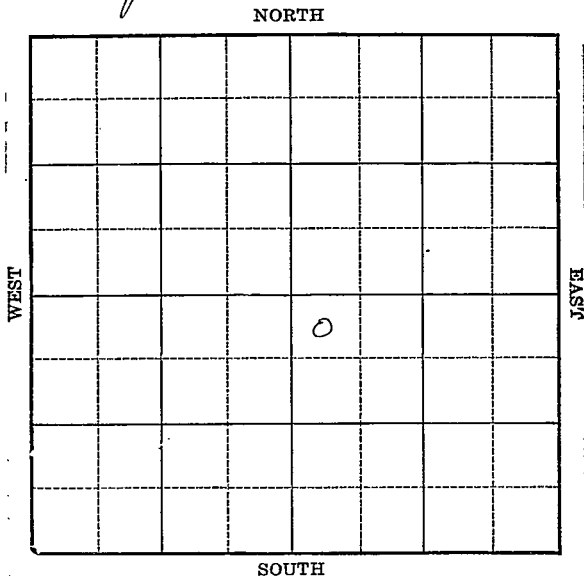

Location _____

Drilling Remarks _____

RECORD

Cased _____ in. _____ ft.
 Sand _____
 Gas _____
 Oil _____
 Total Depth _____

Rig Up _____

Drilling Remarks _____

PRODUCTION

1st 24 hrs. Nat. _____
 1st 24 hrs. after shot _____
 Gas _____ cu. ft.
 Dry Hole _____
 Abandoned _____

Well No. 3-1222 Farm


NORTH

Ft. from S. Line

Ft. from E. Line

330 Ft. from W. Line

1932

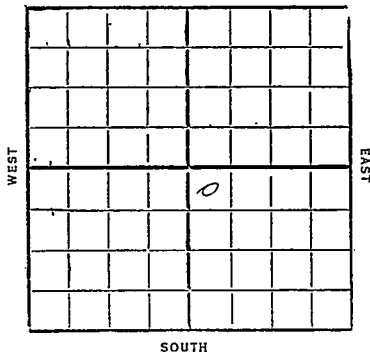

SOUTH

Date _____

REPORT

3/22

3/30

4/6

4/13

4/20

4/27

$$\underline{5/4}$$

5/11

5/18









3/22	Cellar
3/30	Bldg rug
4/6	Rug
4/13	—
4/20	Ext sur pipe
4/27	Shut down
5/4	—
5/11	—
5/18	—
5/25	—
6/1	—
6/8	—
6/15	—
6/22	—
6/29	—
7/6	—
7/13	—
7/20	—
7/27	—
8/3	—
8/10	12"-119
	Dreg 9/5'

8/17- drlg 2860'
8/24- Top chat 2907
drlg 3245'
8/31- Top Viola 3382
Core 3388
shaw saturation
9/7- SD 3388'
9/14- TD 3418
swab 6 bbl per hr
9/21- TD 3419
P.B. to 3418
shot 15 qt
swab 15 to 18 bbl hour
P.B. to 3416
On pump - No test
9/28- P.B. 3413
Made 25 bbl per hr
10/5- Viola 3382-3419
TD 3419
shot 15 qt
P.B. 3413
Potential prod
516 bbl oil
Comp.

43

KANSAS

Map No. _____ Sec. 76 Twp. 19 R. 2^WWell No. 3 underDerby Oil & Texas Company

Contractor _____

FIRST REPORTS

SECTION PLAT

		0	

330 Ft. from N. Line

_____ Ft. from S. Line

_____ Ft. from E. Line

330 Ft. from W. Line

Location _____

Rig up _____

Drilling and Remarks:

RECORD

Cased _____ in., _____ ft.

Sand _____

Gas _____

Oil _____

Total Depth _____

PRODUCTION

1st 24 hrs. Nat. _____

1st 24 hrs. after shot _____

Gas _____ Cu. Ft.

Dry Hole _____

Abandoned _____

Date

MAR 22 1932

19

CHAS. L. CHERWOOD

Scout

[Handwritten signature]

Returned	
Cards	
Tracing	<i>[Handwritten initials]</i>
France Map	<i>[Handwritten mark]</i>
Scarborough Map	<i>[Handwritten mark]</i>
Moody Map	<i>[Handwritten mark]</i>
Scarborough Plat Book	
Moody Plat Book	

43 KANSAS

Map No. _____ Sec. 26 Twp. 19 R. 2

Well No. 3

Derby Oil & Texas Company

Contractor

COMPLETED

SECTION PLAT

330 Ft. from N. Line

Ft. from S. Line

Ft. from E. Line

330 Ft. from W. Line

Location _____

Rig up _____

Drilling and Remarks:

Shot 15 gts
PB to 3413Potential prod
516 bbls.

RECORD

Cased _____ in., _____ ft.

Sand 1/2 solar 3382-3419

Gas _____

Oil _____

Total Depth 3419

PRODUCTION

1st 24 hrs. Nat. _____

1st 24 hrs. after shot _____

Gas _____ Cu. Ft.

Dry Hole _____

Abandoned _____

Date

OCT 5 1932 CHAS. L. SHERWOOD

192 _____ Scout

Handwritten scribbles and lines, possibly a signature or initials, located above the stamp.

Returned	<i>[Signature]</i>
Cards	<i>[Signature]</i>
Tracing	<i>[Signature]</i>
France Map	<i>[Signature]</i>
Scarborough Map	<i>[Signature]</i>
Moody Map	<i>[Signature]</i>
Scarborough Plat Book	
Moody Plat Book	