

KANSAS

McPherson


FORM 51 5M 4-41 PETROL

Section 26 Township 19 Range 2-W

Well No. #1 Unruh

Company Nadel & Gussman et al

NORTH Ritz Canton Pool

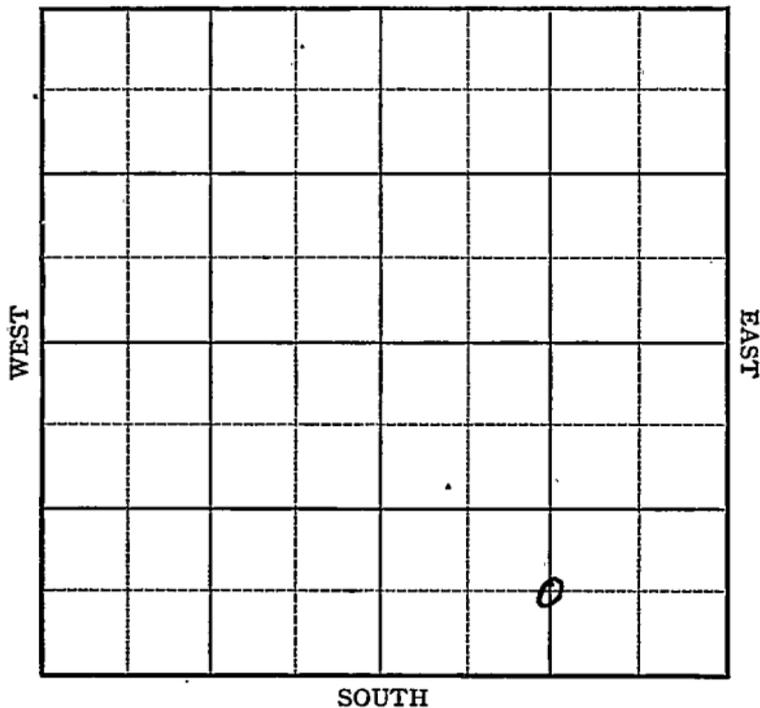

Sec. 26 Twp. 19 R. 2-W

Well No. #1 Unruh Farm

Nadel & Gussman et al Company

(Ritz Canton)


 Ft. from N. Line

660 Ft. from S. Line

1320 Ft. from E. Line

 Ft. from W. Line

Elev. 1539

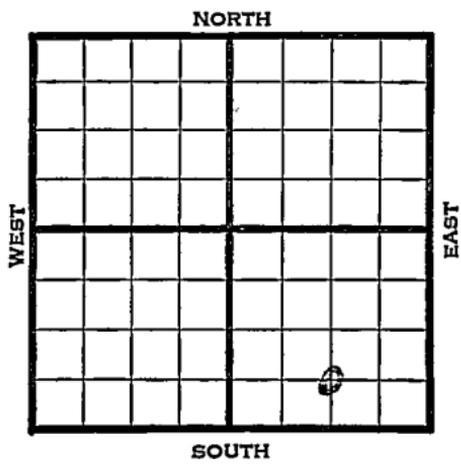

| 1941 | REPORT |
|------|-----------------------------------|
| 5/14 | Location |
| 5/22 | Rigging up. |
| 5/28 | " " |
| 6/5 | " " |
| 6/12 | SD 300' |
| 6/19 | 15" - 941' 13" - 645' |
| | Drlg. 950' |
| 6/26 | 10" - 1615' Drlg. 1745' |
| 7/3 | 8" - 2235' |
| | SD 2230' |
| 7/10 | Lans. 2295' 6" - 2453' |
| | Drlg. 2610' |
| 7/17 | " " |
| 7/24 | Miss 2910 5?" @ 2913 TD 2967 PRP. |
| 7/31 | SD. |
| 8/7 | " |
| 8/15 | 1100' Fluid 25% wat. |
| | Est. 50 bbls oil 5 water natural |
| | Rig up pump. |
| 8/21 | " " " " |
| 8/28 | " " " " |

OVER

1941

9/3

Miss. 2910'

5" - 2913'

T.D. 2967'

Pump 50 oil & 5 water.

41.2 Gravity

COMPLETED

Map No. 43 Sec. 26 Twp. 19 R. 2WWell No. 1 UnruhNadel & Gussman etal Company**FIRST REPORT**


Contractor

C S $\frac{1}{2}$ SE

_____ Ft. from N. Line

660 Ft. from S. Line1320 Ft. from E. Line

_____ Ft. from W. Line

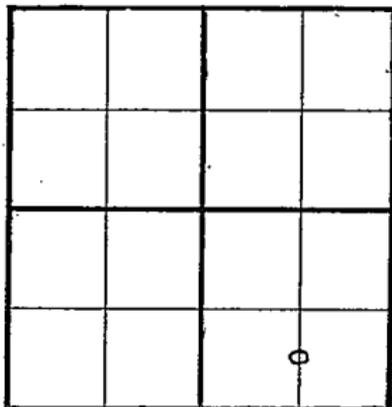RITZ CANTON POOL**SECTION PLAT**Location X

Rig up _____

Drilling and Remarks:

RECORD

Cased _____ in., _____ ft.

Sand _____

Gas _____

Oil _____

Total Depth _____

PRODUCTION

1st 24 hrs. Nat. _____

1st 24 hrs. after shot _____

Gas _____ Cu. Ft.

Dry Hole _____

Abandoned _____

Date

MAY 14 1941 19S. J. LEWIS Scout

Misc Small Maps

Cards

Tracing

France Map

Scarborough Map

Moody Map

Geological Dept.

Moody Plat Book

DMJ
1911
Geo
DMJ
Geo

Map No. 43 Sec. 26 Twp. 19 R. 2W

Well No. 1 Unruh


Nadel & Gussman etal Company

Contractor

COMPLETED

SECTION PLAT

C $S\frac{1}{2}$ SE

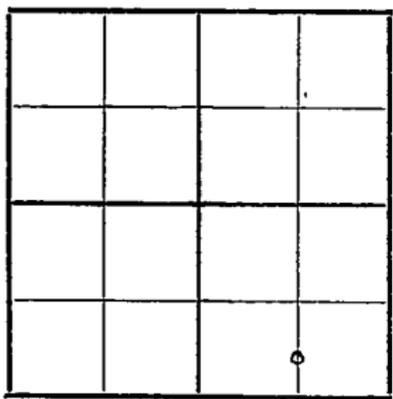

_____ Ft. from N. Line

660 Ft. from S. Line

1320 Ft. from E. Line

_____ Ft. from W. Line

RITZ CANTON POOL

Location _____

Rig up _____

Drilling and Remarks:

Misc 2910
5" @ 2913
Pump 50 oil
5 Wa Tel.
H/2 Gr.

RECORD

Cased _____ in., _____ ft.

Sand _____

Gas _____

Oil _____

Total Depth 2967

PRODUCTION

1st 24 hrs. Nat. _____

1st 24 hrs. after shot _____

Gas _____ Cu. Ft.

Dry Hole _____

Abandoned _____

Date

SEP 3 1941 19

S. J. LEWIS Scout

Misc. Small Maps
Cards
Tracing
France Map
Scarborough Map
Moody Map
Geological Dept.
Moody Flat Book

[Handwritten signature]
[Handwritten signature]