

KANSAS


McPherson

FORM 51 5M 4-41 PETROL

Section 26 Township 19 Range 2-W

Well No. #1 Thompson

Company Nadel & Gussman et al

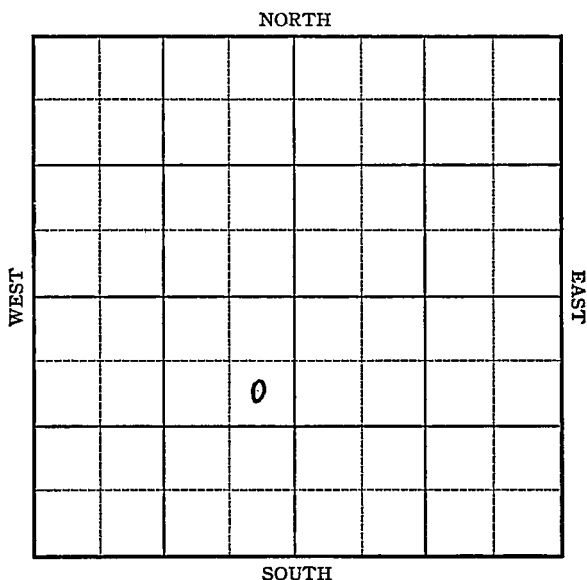

KANSAS


McPherson

Sec. 26 Twp. 19 R. 2-WWell No. #1 Thompson FarmNadel & Gussman et al Company.

(Ritz - Canton)

990 Ft. from N. Line Ft. from S. Line330 Ft. from E. Line Ft. from W. Line

Elev. 1530

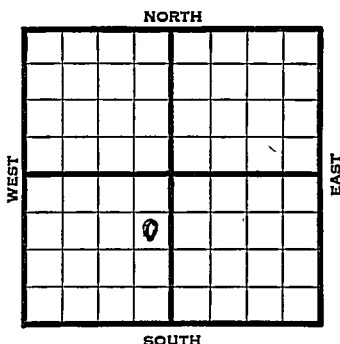

1941	REPORT
10/29	8" - 134'
	Drl'g. 935'
11/6	Drl'g. 2780'
11/13	Miss. 2906-20' T.D. 5" - 2913'
	RUST.
11/20	TD 2928' SD.
11/28	Recement.
12/4	"
12/11	Pay 2943-53 TD 1600' Fluid
12/18	SD
12/24	"
12/30	Miss 2906
	5" @ 2913
	TD 2953
	Pump 10 oil 75 Water Pot.
	41 Grav.

COMPLETED

Map No. K-43 Sec. 26 Twp. 19 R. 2WWell No. 1 ThompsonNadel & Gussman et al Company**FIRST REPORT** Contractor

SE NE SW

SECTION PLAT

990 Ft. from N. Line Ft. from S. Line330 Ft. from E. Line Ft. from W. Line

RITZ CANTON POOL

Location Rig up

Drilling and Remarks:

8" - 134'

Drlg. 935'

RECORD

Cased in., ft.Sand Gas Oil Total Depth

PRODUCTION

1st 24 hrs. Nat. 1st 24 hrs. after shot Gas Cu. Ft.Dry Hole Abandoned

Date

OCT 29 1941

S. J. LEWIS Scout

Map No. 43 Sec. 26 Twp. 19 R. 2WWell No. 1 ThompsonNadel & Gussman et al. Company**COMPLETED**

Contractor

SE NE SW

SECTION PLAT

990 Ft. from N. Line Ft. from S. Line330 Ft. from E. Line Ft. from W. Line

RITZ CANTON POOLLocation Rig up

Drilling and Remarks:

*Mus 2906**5' C 2913**Pump 10 oil to water**28**410 Gr***RECORD**Cased in., ft.Sand Gas Oil Total Depth 2853**PRODUCTION**1st 24 hrs. Nat. 1st 24 hrs. after shot Gas Cu. Ft.Dry Hole Abandoned

Date

DEC 30 1941

19

S. J. LEWIS Scout