


Section 26 Township 19 Range 11W

Well No. #1 Opie

Company Honaker Drlg.

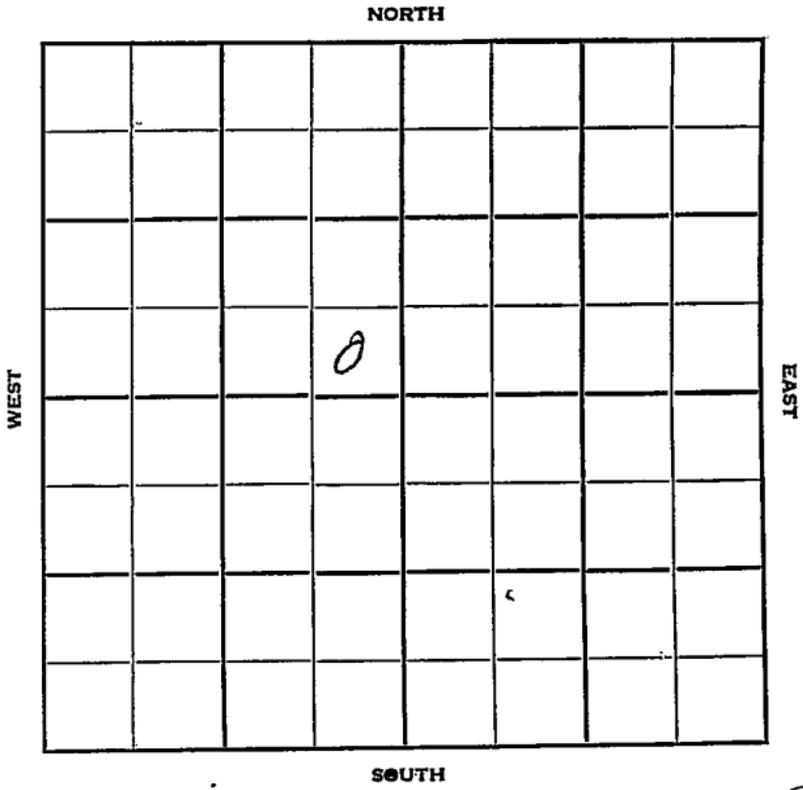

Barton

KANSAS

Sec. 26 Twp. 19 R. 11W

Well No. #1 Opie Farm

Honaker Drlg. Company

Honaker Drlg. Contractor

Great Bend Pool


Ft. from N. Line

330 Ft. from S. Line

330 Ft. from E. Line

Ft. from W. Line

SE SE NW

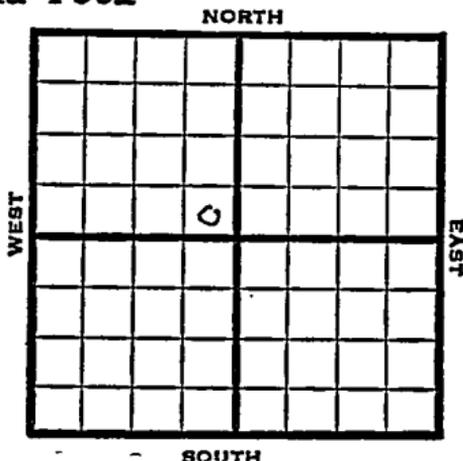

1952

Elev. 1873' REPORT

1/2

Spud 12-19-51
8" @ 793'
Anhy 790 Heeb. 3088
Br. Li 3179 Lans. 3191
DST 3225-42 open 45 min.
Rec. 110' OCM
DST 3339-58 open 45 min.
Rec. 12' mud
Cong. 3430 Arb. 3517-57 TD

2/6

Spud 12-19-51 Oil Well TD 3557
Anhy 790 8" @ 793
Heeb. 3088 Br lime 3179
Lans. 3191
DST 3225-42 opn 45 min. Rec. 110'
ocm DST 3339-58 opn 45 min
Rec. 12' mud Cong. 3430
Arb. 3517-57 5" @ 3556'
CO to 3541 12/3526-29 400' sw 1/2 hr.
PB 3521 10/3516-19 250 A wtr
PB 3430 24/3357-61 1000 A
15 go 6 gwph PB 3334
12/3320-24 SO 12/3320-24
FU 1900' oil 40 min. S/9 boph
1500 A F/41 bo 5 hr.
Comp. BHB 1272 bopd

COMPLETED


County Barton State Kansas

Sec. 26 (Blk. 19) (Sur. Rge. 14W) Map No.

Operator Honaker Drlg.

Well No. 1 Farm Opie

Elev. Location SE SE NW

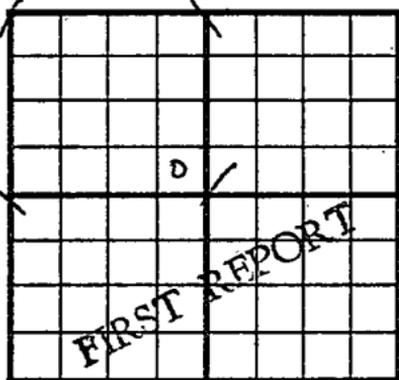

330 Ft. From S Line NW

330 Ft. From E Line Quarter

Ist. Report JAN 2 1952

Completion

Remarks

Honaker Drlg. - Contr.

Spudding Date 12-19-51

Drlg. Data Great Bend Pool

Anhy 790 8" @ 793 Heeb. 3088


Br. line 3179 Lans. 3191 DST 3225-42

open 45 min. Rec. 110^r ocm DST 3339-58

open 45 min. Rec. 12^r mud Cong. 3430

Arb. 3517-57 TD

J. E. TYRA

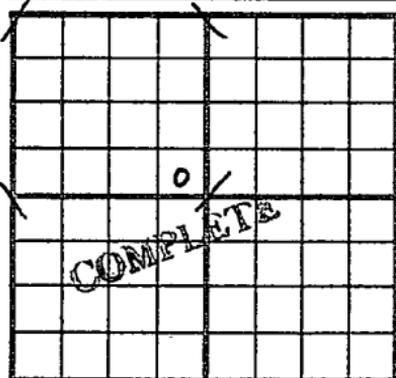County Barton State KansasSec. 26 (Blk.
Twp.) 19 (Sur.
Rge.) 14W Map No.Operator Honaker Drlg.Well No. 1 Farm OpieElev. 1873 Location SE SE NW330 Ft. From S Line NW330 Ft. From E Line Quarter

1st. Report

Completion FEB 6 1952Remarks Great Bend PoolHonaker Drlg. - Contr.Spudding Date 12-19-51Drlg. Data Oil well TD 3557Anhy 790 8" @ 793 Heeb. 3088Br. lime 3179 Lans. 3191 DST 3225-42open 45 min. Rec. 110' ocm DST 3339-58open 45 min. Rec. 12' mud Cong. 3430Arb. 3517-57 5" @ 3556 CO to 354112/ 3526-29 400' sw $\frac{1}{2}$ hr. PB 352110/ 3516-19 250 A ~ water PB 343024/ 3357-61 1000 A ~ 15 go 6 gwphPB 3334 12/ 3320-24 SO 12/ 3320-24FU 1900' oil 40 min. S/ 9 boph1500 A F/ 41 bo 5 hr.Comp. BHB 1272 bopd

J. G. McGEHEE