
FORM 51 25M 8-50 WESTERN Barton KANSAS

Section 26 Township 19 Range 14 W

Well No. #2 Essmiller

Company Marmad Oil

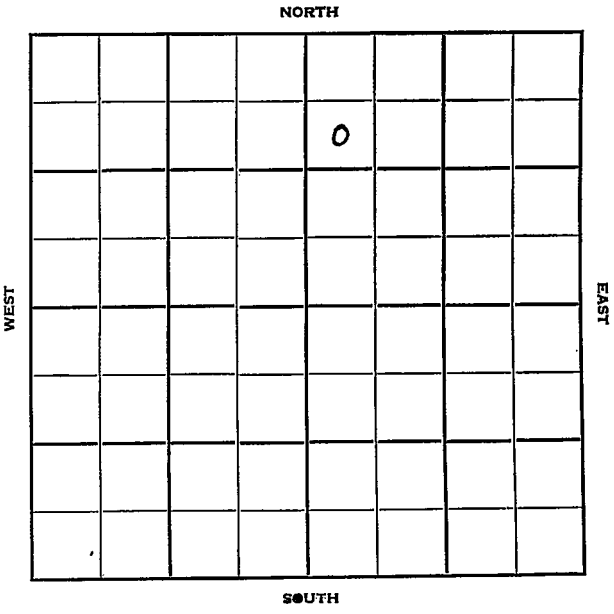

FORM 252-B
10M 10-50 PETROL Barton

KANSAS ✓

Sec. 26 Twp. 19 R. 14W

Well No. #2 Essmiller Farm

Marnard Oil Company

Fleming & Woodman Contractor

Great Bend Airport Pool


990 Ft. from N. Line

Ft. from S. Line

Ft. from E. Line

330 Ft. from W. Line

SW NW NE

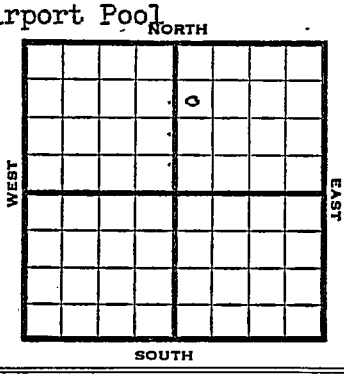

1952	Elev. 1874' REPORT
2/20	Spud 2-17-52 Anhy 792' 8" @ 801' WOC
3/5	KC 3187 RTD 3475 5" set
3/11	5" @ 3475 CO to 3340 24/ 3328-33 1000 A PB 3310 6/ 3258-60 1000 A PB 3253 24/ 3235-43 500 A PB 3229½ 9/ 3222-25 1000 A PB 3218 12/ 3196-3200 1000 A
3/19	Cong. 3416? Sq. off perfs. 23/ 3223-30 1000 A S/ 2 boph POP
3/25	NR
4/1	NR
4/9	"
4/23	Lans. 3193 Cong. 3424 RTD 3475
4/30	NR
5/7	NR
5/14	"
5/21	"
5/28	"
6/11	24/3385-91 To A
6/18	NR

OVER

1952

6/25 NR

7/2 Spud 2-17-52
D & A TD 3475' Anhy 792'
8" @ 801 KC 3187' TD 3475
5" @ 3475 CO to 3340 24/3328-33
1000 A PB 3310 6/3258-60
1000 A PB 3253 24/3235-43 500 A
PB 3229 9/3222-25 1000 A
PB 3218 12/3196-3200 1000 A
Cong. 3416 23/3223-30 1000 A
~~XXXXX~~ S/2 BOPH Lans. 3193'
Cong. 3424' 24/3385-91
D & A

ABANDONED

FORM 275 FOR SALE BY KANSAS BLUE PRINT CO.


County Barton State Kansas

Sec. 26 (Blk. Twp.) 19 (Sur. Rge.) 14W Map No.

Operator Marmad Oil

Well No. 2 Farm Essmiller

Elev. Location SW NW NE

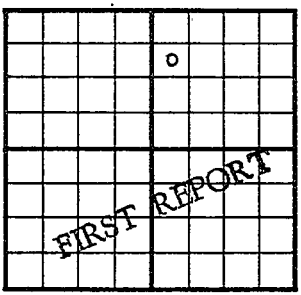

990 Ft. From N Line NE

330 Ft. From W Line Quarter

1st. Report FEB 20 1952

Completion

Remarks Flemming & Woodman -Contr

Spudding Date 2-17-52

Drlg. Data Great Bend Airport Pool

Anhy 792 8" @ 801 WOC

J. G. McGEHEE

FORM 275 FOR SALE BY KANSAS BLUE PRINT CO.


County Barton State Kansas

Sec. 26 (Blk. Twp.) 19 (Sur. Rge.) 14W Map No.

Operator Marmad Oil

Well No. 2 Farm Essmiller

Elev. 1874 Location SW NW NE

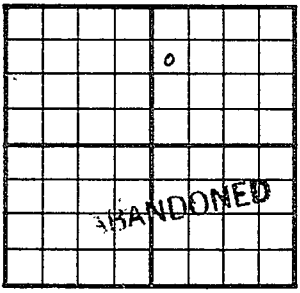

990 Ft. From N Line NE

330 Ft. From W Line Quarter

1st. Report

Completion JUL 2 1952

Remarks Gt. Bend Airport

Flemming & Woodman - Contr

Spudding Date 2-17-52

Drlg. Data D & A TD 3475

Anhy 792 8" @ 801 KC 3187

TD 3475 5" @ 3475 CO to 3340

24/ 3328-33 1000 A PB 3310 6/ 3258-

60 1000 A PB 3253 24/ 3235-43 500 A

PB 3229 9/ 3222-25 1000 A PB 3218

12/ 3196-3200 1000 A Cong. 3416

23/ 3223-30 1000 A S/ 2 boph Lans. 31

3193 Cong. 3424 24/ 3385-91

D & A

I G. McGEHEE