
FORM 51 25M 3-49 PETROL Barton

KANSAS

Section 26 Township 19 Range 11W

Well No. #2 Opie

Company Honaker Drlg.

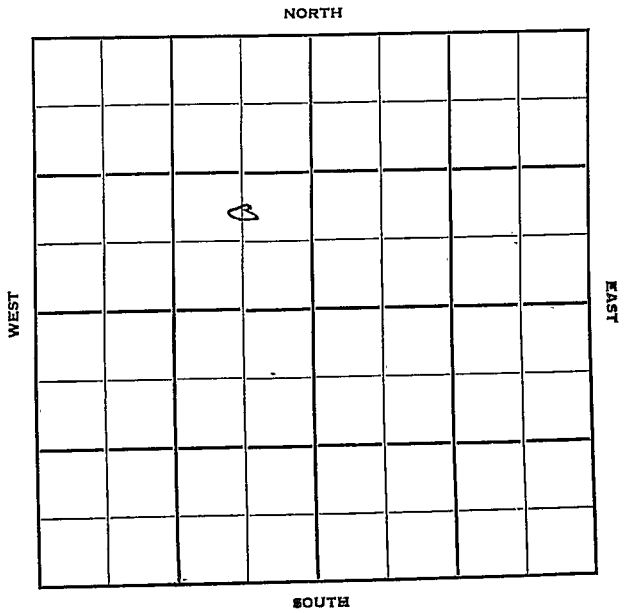

FORM 252-B Barton KANSAS ✓

Sec. 26 Twp. 19 R. 14W

Well No. #2 Opie Farm

" Honaker Drlg. Company

" " Contractor


____ Ft. from N. Line

990 Ft. from S. Line

660 Ft. from E. Line

____ Ft. from W. Line

C N L SE NW

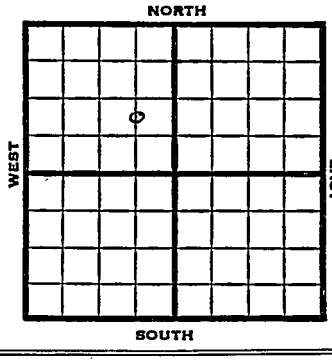

1952	Elev. 1875' REPORT
11/12	Spud 11-7-52 8" @ 800'
11/20	Drlg. 3075'
11/27	NR
12/3	RTD 3508 5" @ 3507 Tite Hole
12/11	Heeb 3091 Brl 3184 Lans 3196 Cong 3417 Arb 3471 RTD 3510 5" @ 3510 CO 3504 6/3498-3500NS 6/ 3490-93NS 71/3482 -87 NS PB 3476 11/3324-28 16 GOPH 250A S/4 BOPH 4 Hrs. POP
12/18	NR
12/25	NR
1/1	NR
1/8	NR
1/22	"
1/29	NR
2/4	Spud 11-7-52 OilWell TD 3510 8" @ 800' Anhy 800, Heeb 3091, Br lime 3184, Lans 3196 DST 3197-3209, opn 1 hr., rec.

OVER

#2 Opie
(Inforamtion BroughtForward)

1952
2/4 15' socm
DST 3239-65, opn 3/4 hrs., rec. 1080' sw
DST 3318-35, opn 45 mins., gas in 14 mins., 30' muddy oil, 300' oil, 590#
Cong 3417, Arb. 3471
TD 3510
5" @ 3510
CO to 3504
6/3498-3500, 6/3490-93,
11/3482-87, PB 3476
11/3324-28, B/16 goph 8 hrs., 250A, B/4 boph
Comp. 163 bopd

COMPLETED

FORM 275 FOR SALE BY KANSAS BLUE PRINT CO.


County Barton State Kansas

Sec. 26 (Blk. Twp.) 19 (Sur. Rge.) 1 W Map No.

Operator Honaker Drlg.

Well No. 2 Farm Opie

Elev. Location C N L SE NW

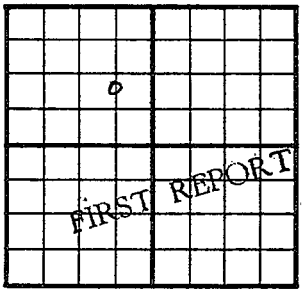

990 Ft. From S Line NW

660 Ft. From E Line Quarter

1st. Report NOV 12 1952

Completion

Remarks Honaker Drlg. - Contr.

Spudding Date 11-7-52

Drlg. Data

8"@ 800

J. G. McGEHEE

FORM 275 FOR SALE BY KANSAS BLUE PRINT CO.


County Barton State Kansas

Sec. 26 (Blk. Twp.) 19 (Sur. Rge.) 14W Map No.

Operator Honaker Drlg.

Well No. 2 Farm Opie

Elev. 1875 Location C N L SE NW

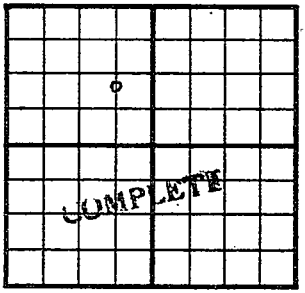

990 Ft. From S Line NW

660 Ft. From E Line Quarter

1st. Report

Completion FEB 4 1953

Remarks

Honaker Drlg. - Contr.

Spudding Date 11-7-52

Drlg. Data Oil well TD 3510

8" @ 800 Anhy 800 Heeb. 3091

Br. lime 3184 Lans. 3196 DST 3197-3209

open 1 hr. Rec. 15' socm DST 3239-65

open 3/4 hr. Rec. 1080' sw DST 3318-35

open 47 min. gas in 14 min. 30' muddy

oil 300' oil 590# Cong. 3417

Arb. 3471 TD 3510 5" @ 3510

CO to 3504 6/ 3498-3500 6/ 3490-93

11/ 3482-87 PB 3476 11/ 3324-28

B/ 16 goph 8 hr. 250 A B/ 4 boph

Comp. 163 bopd

J. G. McGEHEE