


Section 26 Township 19 Range 14W

Well No. #2 Russell

Company Hilton

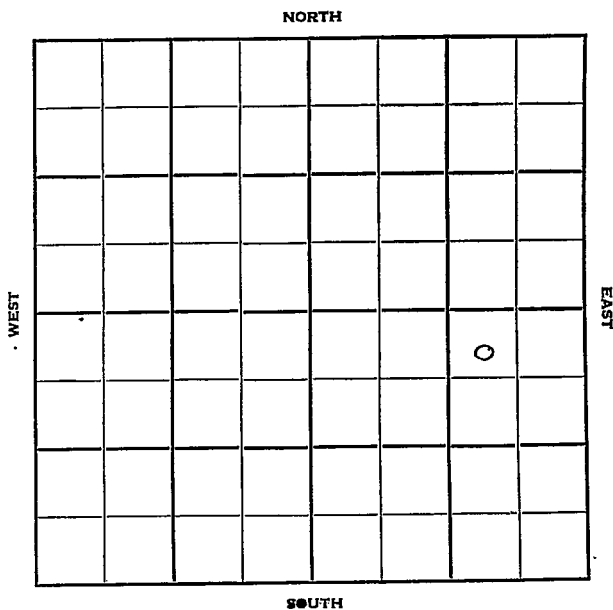

Sec. 26 Twp. 19 R. 14W

Well No. #2 Russell Farm

Hilton Company

Hilton Contractor

Great Bend


330 Ft. from N. Line

_____ Ft. from S. Line

990 Ft. from E. Line

_____ Ft. from W. Line

NW NE SE

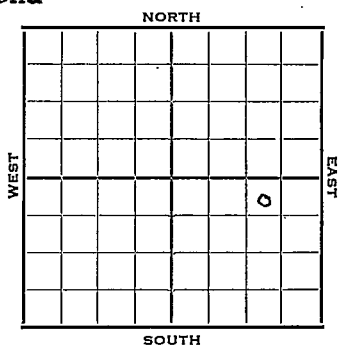

1952 Elev. 1868' REPORT

1/16 RUR
 2/6 TD 3518 5" @ 3517 To PB
 2/13 20/3198-3203' 3500 A
 S/5 BOPH POP
 2/20 POP
 3/5 NR
 3/11 "
 3/19 "
 3/26 Spud 1-15-52
 Oil Well TD 3518
 Anhy 779 8" @ 794 Heeb. 3085
 Lans. 3190
 DST 3240-67 open $\frac{1}{2}$ hr. rec. 75' mud
 DST 3309-31 open $\frac{1}{2}$ hr rec. 10' mud
 DST 3331-46 open $\frac{1}{2}$ hr. rec. 10' mud
 ReArb. 3467 Arb. 3472
 DST 3468-74 open $\frac{1}{2}$ hr. rec. 15' mud
 TD 3518 5" @ 3517 8/ 3472-74
 500 A HFW PB 3382 30/ 3355-60
 500 A SSO 20/ 3198-3203 3500A
 5 boph Comp. 201 bopd 1% wtr.

COMPLETED

