


Section 26 Township 19 Range 14 WWell No. # 3 EssmillerCompany Honaker Drlg.

NORTH

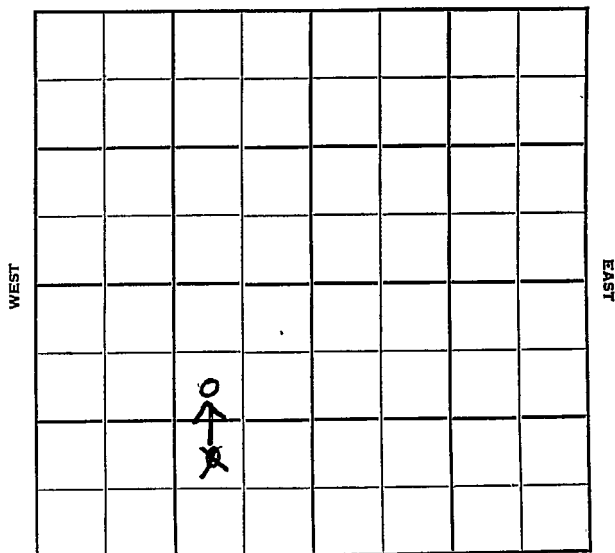

Barton

KANSAS

Sec. 26 Twp. 19 R. 14W

Well No. #3 Essmiller "A" Farm

Honaker Drlg. Company

Honaker Drlg. - Contr. Contractor


990 Ft. from N. Line

~~990~~ Ft. from S. Line

990 Ft. from E. Line

Ft. from W. Line

SW NE SW
NW SE SW

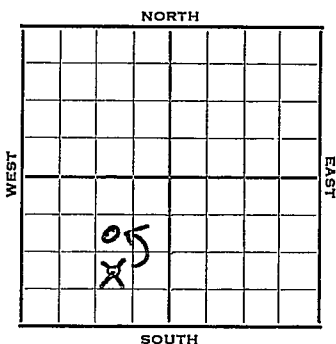

1952	REPORT
4/23	Spud 4-21-52
4/30	8" @ 797' RTD 2500' To Drlg. ahead.
5/7	Heeb 3083' Br 11 3176' Lans. 3188' DST 3190-3200', 20 mins, gas in 4", gas 1 1/4 M, 190 GCM DST 3237-57, 20 mins, gas in 10', 1950' oil. FP 350# Cong. 3424' Arb. 3471' TD 3474' 5" @ 3473 MICT
5/14	DD 34 8 est 1/4 M gas & light spray oil 250A Gauge 691,000 gas DD 3483 250 A Gauge 1,524,000 & light spray oil DD 3485 S/3/4 BOPH 750 A S/load
5/21	F/1 BOPH plus 1 1/2 M gas
5/28	NR
6/11	11/3372-80 F/45 BOPD
6/18	NR
6/25	"
7/2	"

OVER

1952

7/9 Spud 4-21-52
Oil Well TD 3483
8" @ 797
Heeb. 3083 Br Lime 3176
Lans. 3188
DST 3190-3200 opn 20 min. gas
in 4 min. $1\frac{1}{4}$ mcfg 190' gcm
DST 3237-57 opn 20 min. gas in
10 min. Rec. 1950' oil 350# FP
Cong 3424 Arb. 3471 TD 3474
5" @ 3473 DD 3478 $\frac{1}{4}$ mcfg li spray
oil 250 A DD 3483 250 A
1,524,000 gas DD 3485 S/3/4 boph
750 A S/load F/1 boph $1\frac{1}{2}$ mcfg
PB 3400 11/3372-80 F/45 boph
Comp. 3000 bopd

COMPLETED

County Barton State Kansas
 Sec. 26 (Blk. 19 (Sur. 14W Map No.
 (Twp.) (Rge.)
 Operator Honaker Drig.
 Well No. 3 Farm Essmiller
 Elev. Location NW SE SW

FIRST REPORT
 2 See correction

990 Ft. From S Line SW990 Ft. From E Line Quarter1st. Report APR 23 1952Completion correction

Remarks

Honaker Drig. - Contr.Spudding Date 4-21-52

Drlg. Data

Map No. _____ Sec. 26 Twp. 19 R. 14WWell No. 3 Essmiller

Honaker Drlg.

Company

CORRECTION

Contractor

SW NE SW

SECTION PLAT

990 Ft. from N. Line

_____ Ft. from S. Line

990 Ft. from E. Line

_____ Ft. from W. Line

Barton County

Location _____

Rig up _____

Drilling and Remarks:

Reported

NW SE SW

RECORD

Cased _____ in., _____ ft.

Sand _____

Gas _____

Oil _____

Total Depth _____

PRODUCTION

1st 24 hrs. Nat. _____

1st 24 hrs. after shot _____

Gas _____ Cu. Ft.

Dry Hole _____

Abandoned _____

Date

APR 30 1952 19

J. G. McGEHEE


Scout

County Barton State Kansas
 Sec. 26 (Blk.
Twp.) 19 (Sur.
Rge.) 14W Map No.

Operator Honaker Drlg.

Well No. 3 Farm Essmiller "A"

Elev. 1874 Location SW NE SW

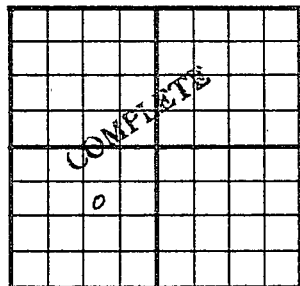

990 Ft. From N Line SW

990 Ft. From E Line Quarter

1st. Report

Completion JUL 9 1952

Remarks

Honaker Drlg. - Contr.

Spudding Date 4-21-52

Drlg. Data Oil well TD 3483

8" @ 797 Heeb. 3083 Br. lime 3176

Lens. 3188 DST 3190-3200 open 20 min.

Gas in 4 min. $1\frac{1}{2}$ mcf/g 190' gcm

DST 3237-57 open 20 min. gas in 10 min.

Rec. 1950' oil 350# FP Cong. 3424

Arb. 3471 TD 3474 5" @ 3473 DD 3478

$\frac{1}{2}$ mcf/g li. spray oil 250 A DD 3483

250 A 1,524,000 gas DD 3485

S/ $\frac{3}{4}$ boph 750 A S/ load

F/ 1 boph $1\frac{1}{2}$ mcf/g PB 3400 11/ 3372-80

F/ 45 boph Comp. 3000 bopd

J. G. McGEHEE