


Section 26 Township 19 Range 13W

Well No. 1 Feldman

Company Hulme Drlg.

14

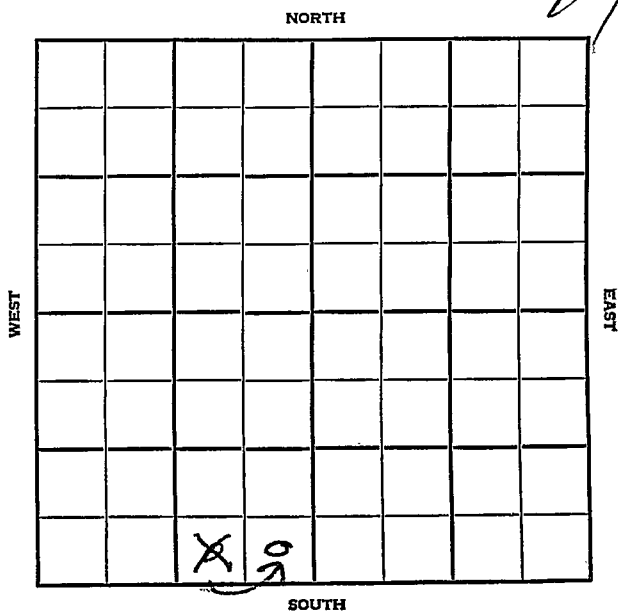

Barton

KANSAS

SEC. 26	TWP. 19	R. 13W
------------	------------	-----------

WELL NO.

#1 Feldmean

FARM

COMPANY

Hulme Drlg.

CONTRACTOR


Greenland
Red Brick

_____ Ft. from N. Line

330 Ft. from S. Line

330 Ft. from E. Line

_____ Ft. from W. Line

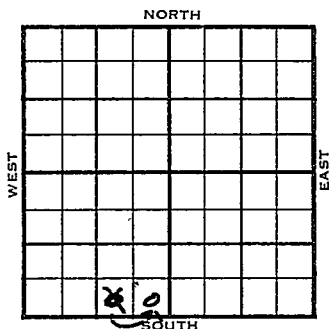

~~SE~~
~~SW~~ SE SW

1955

ELEVATION

1842' RB

REPORT

1839' DF

7/6

Comm. 6-30-55

8" @ 703/375 Drlg. 3000

7/13

Comm. 6-30-55

8" @ 703/375

DST 3165-3238, open 1 hr rec 122'

SO & GCM, 1000#

DST 3433-53, open 1 hr rec 55' HOCM

80#

DST 3453-58 open 1 hr rec 30' OCM

Off.

DST 3458-68 open 1 1/2 hr rec 30' OCM

475/20"

DST 3470-85 open 1/2 hr rec 1380' SW

1000# D & A

Anh. 695'

LOG: H. 3036', BL 3148',

L. 3160', BKG 3388', A. 3428'

TD 3485' D & A

ABANDONED

County Barton Elev. _____
 Sec. 26 Twp. 19 Rge. 13W
 Company Hulme Drlg.
 Farm Name Feldman No. 1

TOPS	DEPTH	LOG	DATUM
Anh.			
TP.			
H.			
Tr.			
Dg.			
Bl.			
L.			
K.C.			
B.K.C.			
Ce.			
C.			
M.			
M.			
K.			
Mz.			
Me.			
V.			
S.			
S.			
A			
R.			
PE.			
G.			
T.D.			

Loc. in Sec. SW SE SW

Geol. _____

Contr. _____

Greenland

Pool _____

Red Brick

FIRST REPORT	
JUL 6 1955	
o	

Date Comm. 6-30-55

8" @ 703/375 drlg. 3000

Co.
Lse.
No.
Sec.
T.
R.

County Barton Elev. 1842 RB
1839 DF
 Sec. 26 Twp. 19 Rge. 13W
 Company Hulme Drlg.
 FarmName Feldman No. 1

TOPS	DEPTH	LOG	DATUM	Loc. in Sec.
Anh.	<u>695</u>			SE SE SW
TP.				
H.		<u>3036</u>	<u>1197</u>	
Tr.				
Dg.				
Bl.		<u>3148</u>	<u>1309</u>	
L.		<u>3160</u>	<u>1321</u>	Geol.
K.C.				Contr.
B.K.C.		<u>3388</u>	<u>1549</u>	<u>Greenland</u>
Ce.				
C.				Pool
M.				<u>Red Brick</u>
M.				
K.				
Mz.				
Mq.				
V.				
S.				
S.				
A.		<u>3428</u>	<u>1589</u>	ABANDONED
R.				
PE.				
G.				
T.D.	<u>3485</u>		<u>1646</u>	<u>0</u>

Date Comm. 6-30-55 **JUL 13 1955**
8" @ 703/375 DST 3165-3238
 open 1 hr. Rec. 122' so & gcm 1000#
 DST 3433-53 open 1 hr. Rec. 55' hocom
 80# DST 3453-58 open 1 hr. Rec.
 30' ocm 0# DST 3458068 open 1½ hr.
 Rec. 30' ocm 475/20" DST-3470-85
 open ½ hr. Rec. 1380' sw 1000#
 D. & A