


Section 26 Township 19 Range 13W
Well No. #1 Hammond
Company Chas. Hulme.

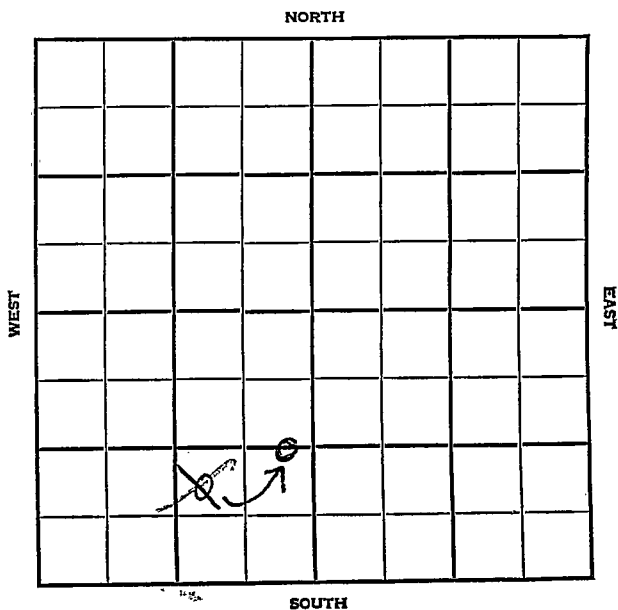

SEC.	TWP.	R.
26	19	13W

WELL NO.

#1 Hammond

FARM

COMPANY

Chas. Hulme.

CONTRACTOR

Co. Tools.


Wildcat.

Ft. from N. Line

Ft. from S. Line

Ft. from E. Line

Ft. from W. Line

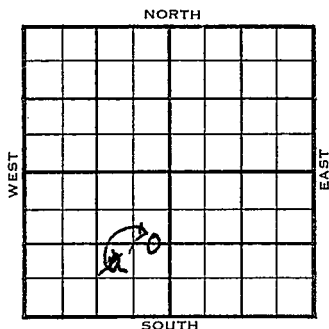

CE 1/2 E 1/2 SW

~~NW SE SW~~

ELEVATION

REPORT

1955

4/6

R U R

6/15

Comm 4-5-55

8 5/8", @400/250 DST 3210-35, open
 1/2 hr. Rec. 180' socm Off DST 3347-75
 open 1/2 hr. Rec 85' socm Off 5 1/2 @ 3499
 DST 3435-55- open 1 hr. Rec. 160' oil
 725/20" perf/3448-52 S/12 boph 500
 A S/325 bo 24 hr. Comp. 143 bopd.

Tops:	Depth	Datum
H.	3035	1196
BL.	3148	1309
L.	3160	1321
A.	3418	1579
TD.	3500	

COMPLETED

FABEN GILSTRAP

SCOUT TICKET

DX-201

Kansas

SEC.

TWP.

R.

26

19

13W

WELL NO.

1 Hammond

FARM

COMPANY

Chas. Hulme

CONTRACTOR

CORRECTION

C E $\frac{1}{2}$ E $\frac{1}{2}$ SW

____ FT. FROM N. LINE

1320


____ FT. FROM S. LINE

330

____ FT. FORM E. LINE

____ FT. FROM W. LINE

NORTH

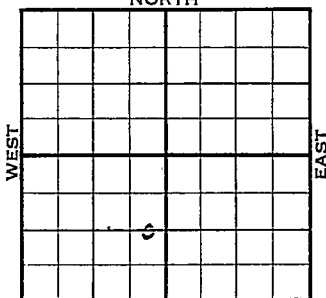

SOUTH

Barton County

☐

LOCATION

☐

RIG UP

DRILLING AND REMARKS:

Reported

NW SE SW

RECORD

CASED IN., FT.

SAND

GAS

OIL

TOTAL DEPTH

1ST 24 HRS. NAT.

1ST 24 HRS. AFTER SHOT

GAS CU. FT.

DRY HOLE

ABANDONED

PRODUCTION

DATE

APR 20 1955

SCOUT

FABEN GILSTRAP

SCOUT TICKET

DX-201

Kansas

SEC.

TWP.

R.

26

19

13W

WELL NO.

1 Hammond

FARM

COMPANY

Chas. Hulme

CONTRACTOR

CORRECTION

C E $\frac{1}{2}$ E $\frac{1}{2}$ SW

____ FT. FROM N. LINE


1320

____ FT. FROM S. LINE

330

____ FT. FORM E. LINE

____ FT. FROM W. LINE

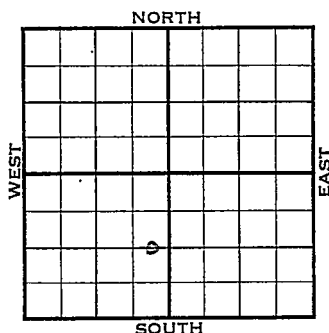

Barton County ✓

☐

LOCATION

☐

RIG UP

DRILLING AND REMARKS:

Reported
NW SE SW

RECORD

CASED IN., FT.

SAND

GAS

OIL

TOTAL DEPTH

1ST 24 HRS. NAT.

1ST 24 HRS. AFTER SHOT

GAS CU. FT.

DRY HOLE

ABANDONED

PRODUCTION

DATE

JUN 15 1955

SCOUT

L. J. Harris

County Barton Elev. 1839 RB
 Sec. 26 Twp. 19 Rge. 13W
 Company Chas. Hulme
 Farm Name Hammond No. 1

TOPS	DEPTH	LOG	DATUM	Loc. in Sec.
Anh.				$E\frac{1}{2}$ $E\frac{1}{2}$ SW
Tr.				
H.	<u>3035</u>		<u>1196</u>	
Tr.				
Dg.				
Bl.	<u>3148</u>		<u>1309</u>	
L.	<u>3160</u>		<u>1321</u>	Geol.
K.C.				Contr.
B.K.C.				
Ce.				
C.				
M.				
M.				Pool
K.				Red Brick
Mz.				
Me.				
V.				
S.				
S.				
A	<u>3418</u>		<u>1579</u>	COMPLETE
R.				
Pe.				
G.				
T.D.	<u>3570</u>			

Date Comm. 4-5-55 JUN 15 1955
8 5/8" @ 400/250 DST 3210-35 open $\frac{1}{2}$ hr.

Rec. 180' socm 0# DST 3347-75

open $\frac{1}{2}$ hr. Rec. 85' socm 0# $5\frac{1}{2}" @ 3499$

DST 3435-55 open 1 hr. Rec. 160' oil

725/20" perf/ 3448-52 S/ 12 boph

500 A S/ 325 bo 24 hr. Comp. 143 bopd