

DX 78-1


BARTON

KANSAS

Section 26 Township 19 Range 13W

Well No. 1 Nicholson

Company H & H Drlg et al 5

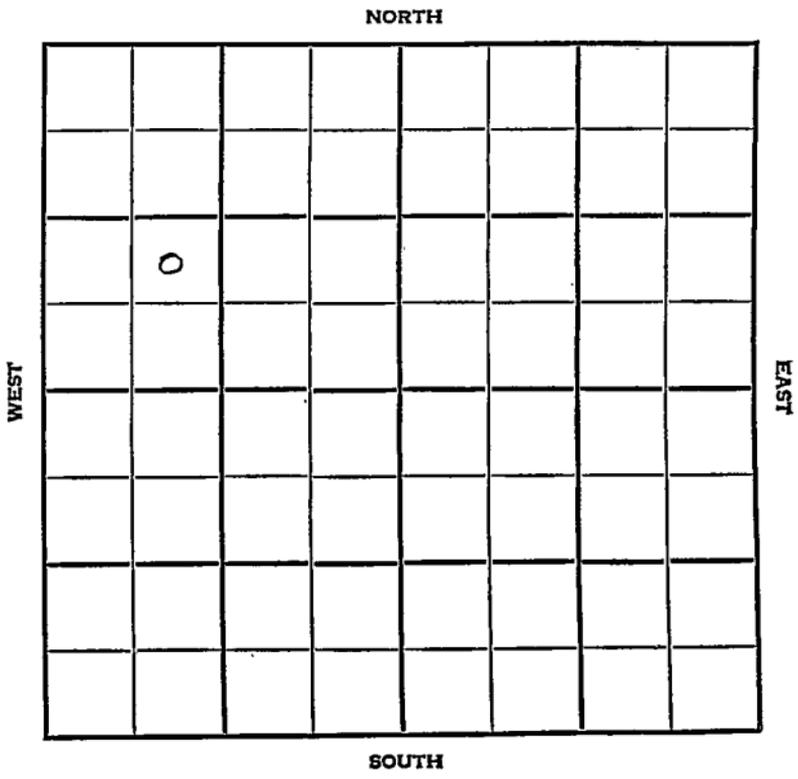

Barton

KANSAS


SEC. 26	TWP. 19	R. 13 W
------------	------------	------------

WELL NO. # 1 Nicholson FARM

COMPANY H & H Drlg. et al

CONTRACTOR Co. tools
Wildcat

_____ Ft. from N. Line
990 _____ Ft. from S. Line
_____ Ft. from E. Line
990 _____ Ft. from W. Line

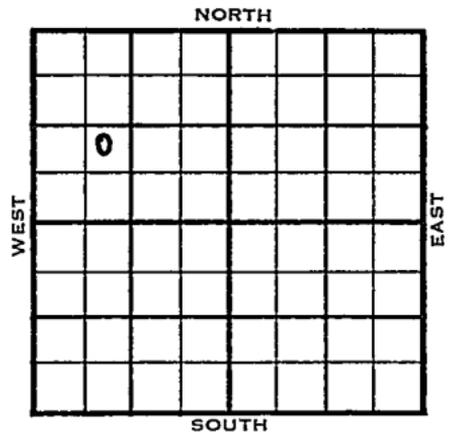

NE SW NW

CRA Farmout

	ELEVATION	REPORT
1955		
3/30		Spud 3-25-55 8" @ 409 Anhy 695' Drlg. 2155'

