


Company Magnolia 5

NORTH

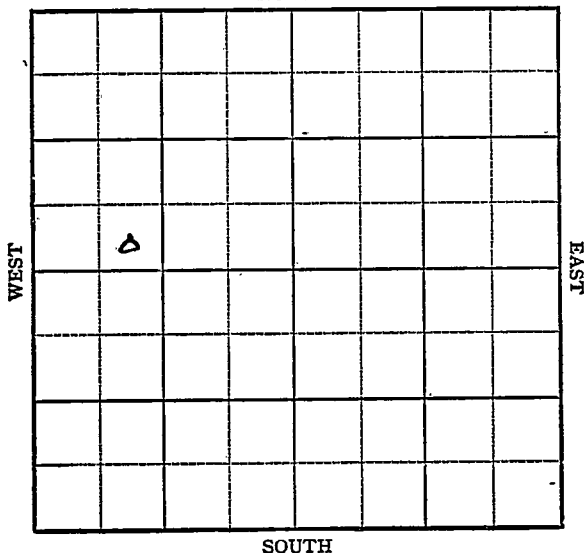

KANSAS

Rush

Sec. 26 Twp. 19 R. 16W

Well No. #1 Dirks Farm

Magnolia Company


Ryan Pool

Ft. from N. Line

330' Ft. from S. Line

Ft. from E. Line

990' Ft. from W. Line

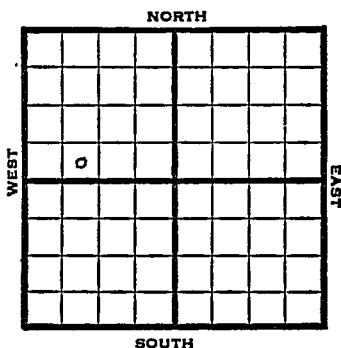~~SE~~
SW NW

1949 Elev 2010' REPORT

1/19 13" @ 195'
1/26 10" @ 1058'
Drlg 1880'
2/2 Drlg. 3030'
2/9 Arbuckle 3706'
6" @ 3740'
TD 3742'
2/16 TD 3755'
1000' oil / 200' W
PB 3749'
2/23 500 acid
Flow 32 bbls oil 24 hrs.
3/2 TDn 3755'
Arb. 3740'
6" @ 3740'
500 acid
Flow 41 Oil Pot 4 M Gas
Comp

COMPLETED

Map No. _____ Sec. 26 Twp. 19 R. 16W

Well No. 1 Dirks

Magnolia Company

FIRST REPORT

Contractor

SE SW NW


SECTION FLAT

_____ Ft. from N. Line

330 Ft. from S. Line

_____ Ft. from E. Line

990 Ft. from W. Line

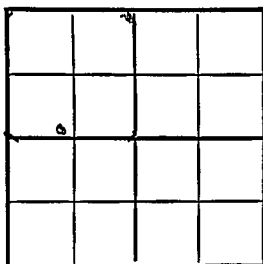

Rush County

RECORD

Location _____

Rig up _____

Drilling and Remarks:

13" @ 195

Cased _____ in., _____ ft.

Sand _____

Gas _____

Oil _____

Total Depth _____

PRODUCTION

1st 24 hrs. Nat. _____

1st 24 hrs. after shot _____

Gas _____ Cu. Ft.

Dry Hole _____

Abandoned _____

Date

JAN 19 1949 19

S. J. LEWIS Scout

Map No. K81 Sec. 26 Twp. 19 R. 16W

Well No. 1 Dirks

Magnolia

Company

COMPLETE

Contractor

SE SW NW

E1.2010
SECTION PLAT

_____ Ft. from N. Line

330

_____ Ft. from S. Line

_____ Ft. from E. Line

990

_____ Ft. from W. Line

Rush County

Location _____

Rig up _____

Drilling and Remarks:

Ar 43706

6" @ 3740

500 acid

Flow 4 1/2 oil per

4M Gas

RECORD

Cased _____ in., _____ ft.

Sand _____

Gas _____

Oil _____

Total Depth *3755*

PRODUCTION

1st 24 hrs. Nat. _____

1st 24 hrs. after shot _____

Gas _____ Cu. Ft.

Dry Hole _____

Abandoned _____

Date

MAR 2 1949 19

S. J. LEWIS

Scout