

KANSAS


Rush County

FORM 51 5M 6-46 PETROL

Section 26 Township 19 Range 16W

Well No. 1 Kenney

Company Champlin Ref.

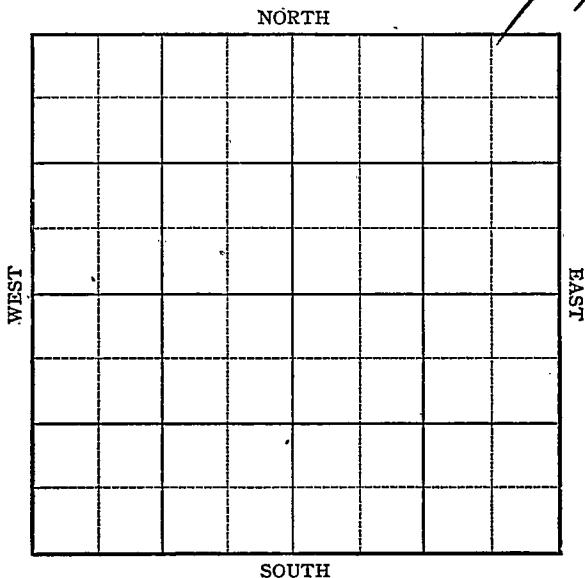

KANSAS


Rush County

Sec. 26 Twp. 19 R. 16WWell No. #1 Kenney Farm

Champlin Ref.

Company

Wildcat

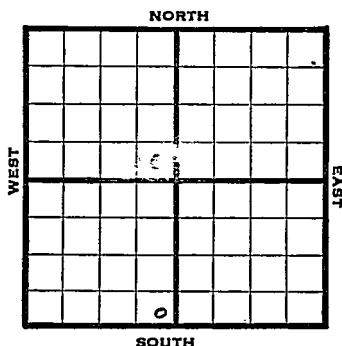 Ft. from N. Line330 Ft. from S. Line330 Ft. from E. Line Ft. from W. LineSE NW SW

1946

1997

REPORT

7/10

Location

8/6

Drlg 3220'

8/13

Anhy 1030'

Lans 3409

Arb 3676

TD 3758

5" @ 3758'

8/20

17 shots 3729-31-500 acid

3 gals W PH

8/27

PB 3725

48 shots 3700-22

9/5

"

"

9/11

Lans 3409'

Arb 3676'

TD 3758'

5" 3 758'

Perf. 500,000

892,000 Gas plus 2 oil a day

Grav. 39

COMPLETED


KANSASKansas Pool Name WildcatMap No. 81 Sec. 26 Twp. 19 R. 16WWell No. 1 McKenneyChamplin Ref.

Company

FIRST REPORT

Contractor

SE SW

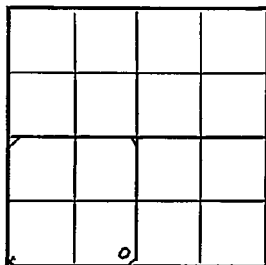SECTION PLAT Ft. from N. Line330 Ft. from S. Line Ft. from E. Line330 Ft. from W. LineRush CountyLocation XRig up

Drilling and Remarks:

RECORDCased in., ft.Sand Gas Oil Total Depth **PRODUCTION**1st 24 hrs. Nat. 1st 24 hrs. after shot Gas Cu. Ft.Dry Hole Abandoned

Date

JUL 10 1946

19

S. J. LEWIS

Scout

~~KANSAS~~

Kansas

Pool Name

Wildcat

Map No.

81

Sec.

26

Twp.

19

R.

16W

Well No.

1 Kenney

Chanplin Ref.

Company


CORRECTION

Contractor

~~SUBMIT~~

SESW

SECTION PLAT

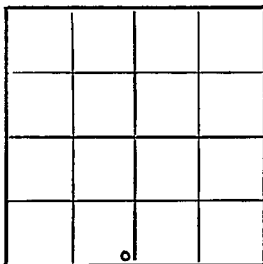

Ft. from N. Line

330

Ft. from S. Line

330

Ft. from E. Line

Ft. from W. Line

Rush County

Location

Rig up

Drilling and Remarks:

Reported 330 from
West line

RECORD

Cased _____ in., _____ ft.

Sand _____

Gas _____

Oil _____

Total Depth _____

PRODUCTION

1st 24 hrs. Nat. _____

1st 24 hrs. after shot _____

Gas _____ Cu. Ft.

Dry Hole _____

Abandoned _____

Date

AUG 7

1946

19

S. J. LEWIS

Scout

KANSAS

Kansas Pool Name WildcatMap No. _____ Sec. 26 Twp. 19 R. 16WWell No. 1 Kenney

Champlin Ref. _____

Company _____

CORRECTION

Contractor _____

SE SW

SECTION PLAT

_____ Ft. from N. Line

330 Ft. from S. Line330 Ft. from E. Line

_____ Ft. from W. Line

Rush County

Location _____

Rig up _____

Drilling and Remarks:

Sent Correction

SE NW

Should be SE SW

RECORD

Cased _____ in., _____ ft.

Sand _____

Gas _____

Oil _____

Total Depth _____

PRODUCTION

1st 24 hrs. Nat. _____

1st 24 hrs. after shot _____

Gas _____ Cu. Ft.

Dry Hole _____

Abandoned _____

Date

AUG 14 1946

19

S. J. LEWIS

Scout

Kansas Pool Name WildcatMap No. 81 Sec. 26 Twp. 19 R. 16WWell No. 1 McKinney

Champlin Ref. _____ Company

COMPLETED

Contractor

SE SW

E 11997

SECTION PLAT

_____ Ft. from N. Line

330 _____ Ft. from S. Line330 _____ Ft. from E. Line

_____ Ft. from W. Line

Rush County

Location _____

Rig up _____

Drilling and Remarks:

Line 8409Ar 36765" @ 3708Prof.892,000 Gas+ 2000 gal. 39 c/gal

RECORD

Cased _____ in., _____ ft.

Sand _____

Gas _____

Oil _____

Total Depth 8758

PRODUCTION

1st 24 hrs. Nat. _____

1st 24 hrs. after shot _____

Gas _____ Cu. Ft.

Dry Hole _____

Abandoned _____

Date

SEP 1 1 1946 19

S. J. LEWIS Scout