

KANSAS

Section 26 Township 19 Range 16W

Well No. #2 McKinney

Company Champlin Ref.
Ryan Pool

13

NORTH

0							

WEST

EAST

SOUTH

KANSAS

Rush County

Sec. 26 Twp. 19 R. 16W

Well No. #2 McKinney Farm

Champlin Ref. Company


 Ft. from N. Line

330 Ft. from S. Line

 Ft. from E. Line

330 Ft. from W. Line

SW/C

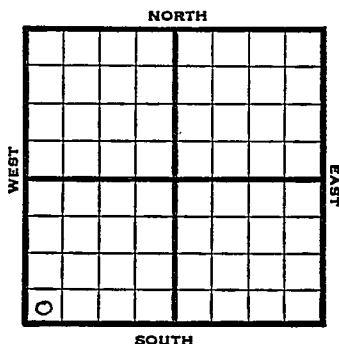

1948 Elev. 2006' REPORT

4/21	RUR
4/28	8" @ 1040' Drlg. 2090'
5/5	Lansing 3414' Simpson 3674' Drlg. 3681'
5/12	TD 3739' 5" @ 3735' RUSE
5/19	"
5/26	TD 3741' 1500' oil 3 hrs.
6/1	"
6/9	Flow 7 bbls oil PH $\neq$ 24% W
6/16	"
6/23	"
6/29	"

OVER

1948

7/8

Arbuckle 3674'

7" @ 3735'

Pump 80 oil & 8% W Pot.

Gr. 38

TD 3744'

COMPLETED

Map No. _____ Sec. 26 Twp. 19 R. 16W

Well No. 2 McKinney

Champlin Ref. _____ Company

FIRST REPORT _____ Contractor

SW/C

SECTION PLAT

_____ Ft. from N. Line

330 _____ Ft. from S. Line

_____ Ft. from E. Line

330 _____ Ft. from W. Line

Rush County

Location _____

Rig up _____

Drilling and Remarks:

R U R

RECORD

Cased _____ in., _____ ft.

Sand _____

Gas _____

Oil _____

Total Depth _____

PRODUCTION

1st 24 hrs. Nat. _____

1st 24 hrs. after shot _____

Gas _____ Cu. Ft.

Dry Hole _____

Abandoned _____

Date

APR 21 1948 19 _____ S. J. LEWIS Scout

Map No. 81 Sec. 26 Twp. 19 R. 16W

Well No. 2 McKinney

Champlin Ref. _____ Company _____

COMPLETE

Contractor _____

SW/C


E1.2006
SECTION PLAT

_____ Ft. from N. Line

330 Ft. from S. Line

_____ Ft. from E. Line

330 Ft. from W. Line

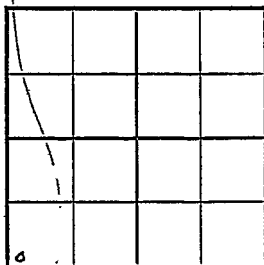

Rush County

RECORD

Location _____

Cased _____ in., _____ ft.

Rig up _____

Sand _____

Drilling and Remarks:

Gas _____

Oil ☒

Total Depth 3741

PRODUCTION

1st 24 hrs. Nat. _____

1st 24 hrs. after shot _____

Gas _____ Cu. Ft.

Dry Hole _____

Abandoned _____

Date

JUL 8 1948 19 S. J. LEWIS Scout