

Section 26 Township 19 Range 16-W

Well No. #1 Tammen

Company Alkay Oil

14

NORTH

WEST

EAST

0

SOUTH

Sec. 26 Twp. 19 R. 16W ✓

Well No. #1 Tammen Farm
Alkay Oil Company
Ryan Pool

_____ Ft. from N. Line

330'


_____ Ft. from S. Line

_____ Ft. from E. Line

330'

_____ Ft. from W. Line

SW SW SE

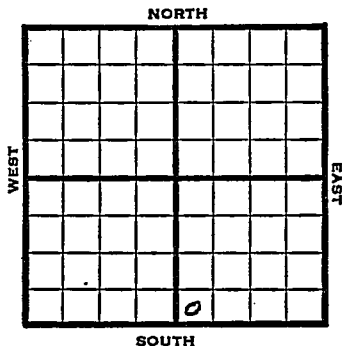

1950 Elev 1996' REPORT

1/11 RUR

3/22 8" @ 1050'
Anhy 1068-1290
Lans 3427'
Arb. 3675'
5" @ 3731'
TD 3738'
1000 acid
TD 3741'
Pump 15 BOPD
Comp 12½ BOPD
Comp

COMPLETED

Kansas

Ryan Pool

Map No. _____ Sec. 26 Twp. 19 R. 16W

Well No. 1 Tammen

Alkay Oil Company

Contractor _____

SW SW SE

SECTION PLAT

_____ Ft. from N. Line

330 Ft. from S. Line

_____ Ft. from E. Line

330 Ft. from W. Line

FIRST REPORT			
		o	

Rush County

Location _____

Rig up _____

Drilling and Remarks:

R U R

RECORD

Cased _____ in., _____ ft.

Sand _____

Gas _____

Oil _____

Total Depth _____

PRODUCTION

1st 24 hrs. Nat. _____

1st 24 hrs. after shot _____

Gas _____ Cu. Ft.

Dry Hole _____

Abandoned _____

Date

JAN 11 1950

J. E. TYRA Scout

Map No. _____ Sec. 26 Twp. 19 R. 16W

Well No. 1 Tammen

Alkay Oil Company

Contractor

SW SW SE

E.I. 1996


SECTION PLAT

_____ Ft. from N. Line

330 Ft. from S. Line

_____ Ft. from E. Line

330 Ft. from W. Line

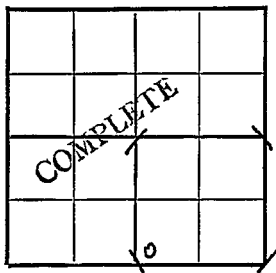

Rush County

Location _____

Rig up _____

Drilling and Remarks:

8" @ 1050
 any 1068-1290
 Kans. 3427
 arb. 3675
 5" c 3731
 T.D. 3738
 1000 acid
 T.D. 3741

RECORD

Cased _____ in., _____ ft.

Sand _____

Gas _____

Oil _____

Total Depth _____

PRODUCTION

1st 24 hrs. Nat. _____

1st 24 hrs. after shot _____

Gas _____ Cu. Ft.

Dry Hole _____

Abandoned _____

Pump 15 bopd
 Date *Comp. 12 1/2 bopd*

MAR 22 1951

J. E. TYRA

Scout