

Section 26 Township 19 Range 16 W

Well No. #1 Hemken "B"

Company C R A

2

NORTH

					0		

WEST

EAST

SOUTH

Rush

KANSAS

SEC.	TWP.	R.
26	19	16W

WELL NO.

#1 Henken "B"

FARM

COMPANY

C R A

CONTRACTOR


Semi wildcat

Ft. from N. Line

Ft. from S. Line

Ft. from E. Line

Ft. from W. Line

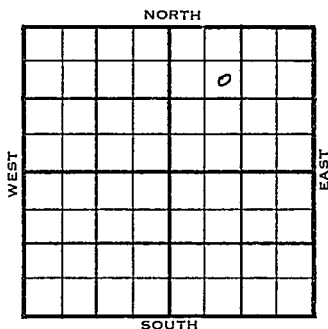

SE NW NE

1955

ELEVATION

2018'

REPORT

9/7

Location

9/28

Comm 9-9-55

8 5/8" @ 1068/525

H

3321

3333

Tr

3350

Dg

3360

3361

Bl

3402

3406

L

3419

3424

BKC

3654

A

3701

3702

TD

3801

DST 3707-31 open 21 hr Rec 70' gc

sul wtr. 975/20" DST 3749-71

open 1 hr Rec 810' gas 190' sowcm

15' sul wtr 175# DST 3730-3801


open 1 hr Rec 1800' gas 600' gc sul
wtr 1050/20"

D&A

ABANDONED

County Rush Elev. _____
 Sec. 26 Twp. 19 Rge. 16W
 Company CRA
 Farm Name Hemken #BII No. 1

TOPS	DEPTH	LOG	DATUM	Loc. in Sec.
Anh.				SE NW NE
Tr.				
H.				
Tr.				
Dg.				
Bl.				
L.				Geol.
K.C.				Contr.
B.K.C.				
Ce.				
C.				
M.				Pool
M.				Semi Wildcat
K.				
Mz.				
Mq.				
V.				
S.				
S.				
A.				
R.				
Pe.				
G.				
TD.				

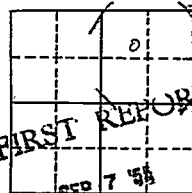

Date Comm. _____
 Location _____

[Handwritten signature/initials]

County Rush Elev. 2018
 Sec. 26 Twp. 19 Rge. 16W
 Company C R A
 Farm Name Hemken "B" No. 1

TOPS	DEPTH	LOG	DATUM	Loc. in Sec.
Anh.				SE NW NE
Tr.				
H.	3321	3333	1315	
Tr.		3350	1332	
Dg.	3360	3361	1343	
BL.	3402	3406	1388	
L.	3419	3424	1406	Geol.
K.C.				Contr.
B.K.C.		3654	1636	
Ce.				
C.				
M.				
M.				Pool
K.				Semi Wildcat
Mz.				
Ma.				
V.				
S.				
S.				
A	3701	3703	1685	
R.				
PE.				
G.				
TR.	3801			

Date Comm. 9-9-55 SEP 28 1955
8 5/8" @ 1068/525 - DST 3707-31 open
1 hr. Rec. 70' gc sul. wtr. 975/20"
DST 3719-71 open 1 hr. Rec. 810' gas
190' sowcm 15' sul. wtr. 175#
DST 3730-3801 open 1 hr. Rec. 1800' gas
600' gc sul. wtr. 1050/20"

D & A