

KANSAS

Rush

Section 26 Township 19 Range 16W

Well No. 3 McKinney

Company Champlin Ref.

Ryan
NORTH

12

WEST

EAST

0							

SOUTH

Rush **KANSAS**

Sec. 26 Twp. 19 R. 16W ✓

Well No. #3 McKinney Farm

Champlin Ref.

Ryan Pool (Champlin Ref. Cont.) Company


330' Ft. from N. Line

_____ Ft. from S. Line

_____ Ft. from E. Line

330' Ft. from W. Line

NW SW

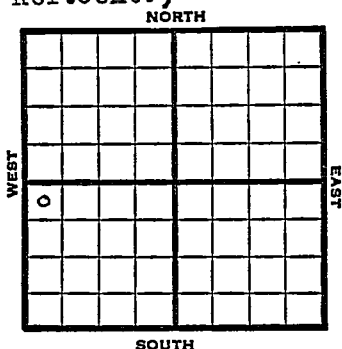

1949 Elev 2028' REPORT

6/8 Location
 6/15 RUR
 6/21 8" @ 1055'
 Drlg 2184'
 6/28 Drlg 3588'
 7/6 Lansing 3450'
 Arbuckle 3747'
 TD 3773'
 7/12 "
 7/20 TD 3775'
 7/27 46 shots 3747-38
 500 acid
 8/3 "
 8/10 TD 3775'
 Arb. 3747'
 5 @ 3773'
 Aband.

ABANDONED

Kansas

Map No. K81 Sec. 26 Twp. 19 R. 16WWell No. 3 McKinney

Champion Ref.

Company

ABANDONED

Contractor

NW SW

E. I. 2028.
SECTION PLAT330 Ft. from N. Line

_____ Ft. from S. Line

_____ Ft. from E. Line

330 Ft. from W. Line

o			

Rush County

RECORD

Location _____

Cased _____ in., _____ ft.

Rig up _____

Sand _____

Drilling and Remarks:

Gas _____

Oil _____

Total Depth 2725

PRODUCTION

1st 24 hrs. Nat. _____

1st 24 hrs. after shot _____

Gas _____ Cu., Ft.

Dry Hole _____

Abandoned _____

Date

AUG 10 10AM 19

S I LEWIS Scout