


Barton

KANSAS

Section 27 Township 19 Range 11W

Well No. #3 Lanterman

Company Alpine Oil & Royalty

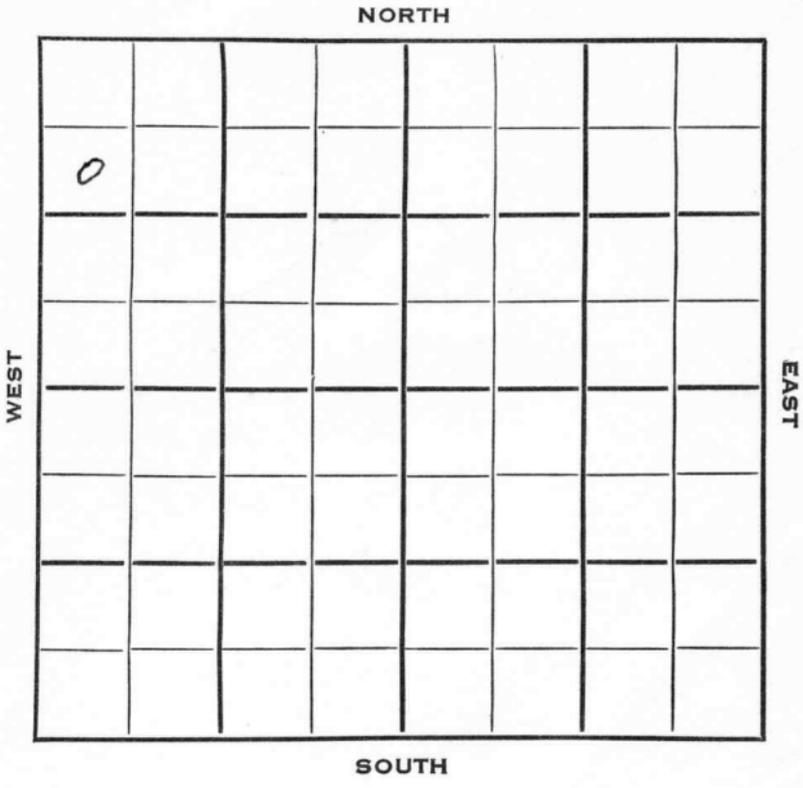

Sec. 27 Twp. 19 R. 11 W

Well No. #3 Lanterman Farm

Alpine Oil & Royalty Company

Contractor

Anton Pool


990 Ft. from N. Line

Ft. from S. Line

Ft. from E. Line

330 Ft. from W. Line

SW NW NW

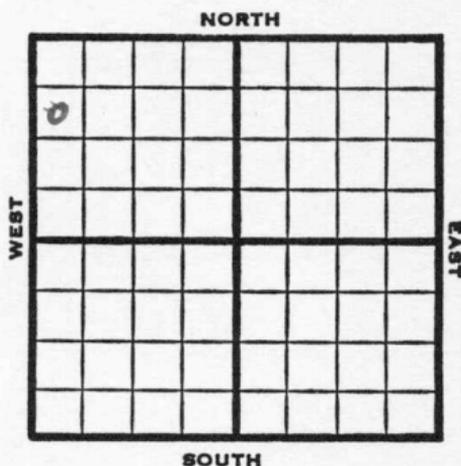

1953 Elev. 1778' REPORT

3/11 Location
 3/19 "
 3/26 "
 4/2 "
 4/9 8" @ 225 Anhy 540-70
 Drlg. 2210'
 4/16 5" Set
 4/23 NR
 4/29 Spud 4-2-53
 Oil Well
 TD 3347'
 8" @ 225'
 Anhy 540, Heeb 2907, Br. Lime 3023,
 Lans 3045,
 DST 3064-3120 opn 1 hr, rec 100' o &
 gcm 1125#
 DST 3222-29 opn 1/2 hr. Rec 660' wtr.
 mud & gas, 910#
 DST 3262-91 opn 1 hr. rec 5' mud, 0#
 Arb 3334,
 TD 3340'
 5" @ 3338'
 DD 3347, 500 A 5 boph
 Comp. 25 bopd.

COMPLETED

County Barton State Kansas

Sec. 27 (^{Blk.}_{Twp.}) 19 (^{Sur.}_{Rge.}) 11W Map No.

Operator Alpine Oil & Royalty

Well No. 3 Farm Lanterman

Elev. _____ Location SW NW NW

0					

990 Ft. From N Line NW

330 Ft. From W Line Quarter

1st. Report MAR 11 1953

Completion _____

Remarks _____

Spudding Date _____

Drlg. Data Anton Pool

Location

Scout Cards *MTM*
Land Small Map
Land Wall Map *3*
Tracings
France Map
Pierce Map
Misc.

MAR 13 1953

County Barton State Kansas
 Sec. 27 (Blk. 19 (Sur. 11W (Twp.) Map No.)
 Operator Alpine Oil & Royalty
 Well No. 3 Farm Lanterman
 Elev. 1778 Location SW NW NW

990 Ft. From N Line NW
330 Ft. From W Line Quarter

Ist. Report
 Completion APR 29 1953
 Remarks Anton Pool
Quaker Drlg. - Contr.
 Spudding Date 4-2-53

Drlg. Data Oil well TD 3347
8" @ 225 Anhy 540 Heeb. 2907
Br. lime 3023 Lens. 3045 DST 3064-3120
open 1 hr. Rec. 100' o & gcm 1125#
DST 3222-29 open 1/2 hr. Rec. 660' wtr.
mud & gas 910# DST 3262-91 open 1 hr.
Rec. 5' mud 0# Arb. 3334 TD 3340
5" @ 3338 DD 3347 500 A 5 boph
Comp. 25 bopd

MAY 6 1953

Scout Cards
Land Small Map
Land Wall Map
Tracings
France Map
World Map
Misc.

Ep

