

Section 27 Township 19 Range 11W

Well No. #1 Lanterman

Company Alpine Oil & Royalty

NORTH

0							

WEST

EAST

SOUTH

Barton

KANSAS

Sec. 27 Twp. 19 R. 11W ✓

Well No. #1 Lanterman Farm

Alpine Oil & Royalty Company

Mid-Western Drlg. - Contr. Contractor

Ft. from N. Line

330'


Ft. from S. Line

Ft. from E. Line

330'

Ft. from W. Line

SW SW NW

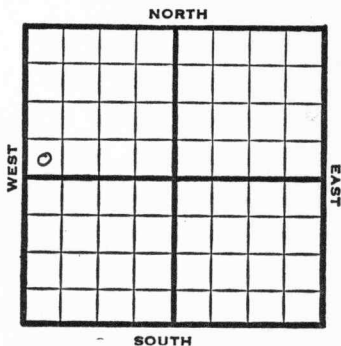

SOUTH

1950

Elev. 1778' REPORT

12/6
1951

Spud 12-4-50

2/14

Spud 12-9-50

8" @ 229' Heeb. 2917'

Br Lime 3034' Lāns 3054'

Arb. 3332-35 5" @ 3333'

TD 3342 FU 550' oil S/2 boph

Comp. 133 bopd 4% wtr.

COMPLETED

J. E. TYRA

Scout Cards
Land Small Map
Land Wall Map
Tracings
France Map
Pierce Map
Misc.

DEC 8 1950

J. E. TYRA

Scout Cards	
Land Small Map	
Land Wall Map	
Tracings	
France Map	
Pierce Map	
Misc.	

FEB 21 1951

Orig. Data

J. E. TYRA