


Section 27 Township 19 Range 11W

Well No. #2 Lanterman

Company Alpine Oil & Royalty

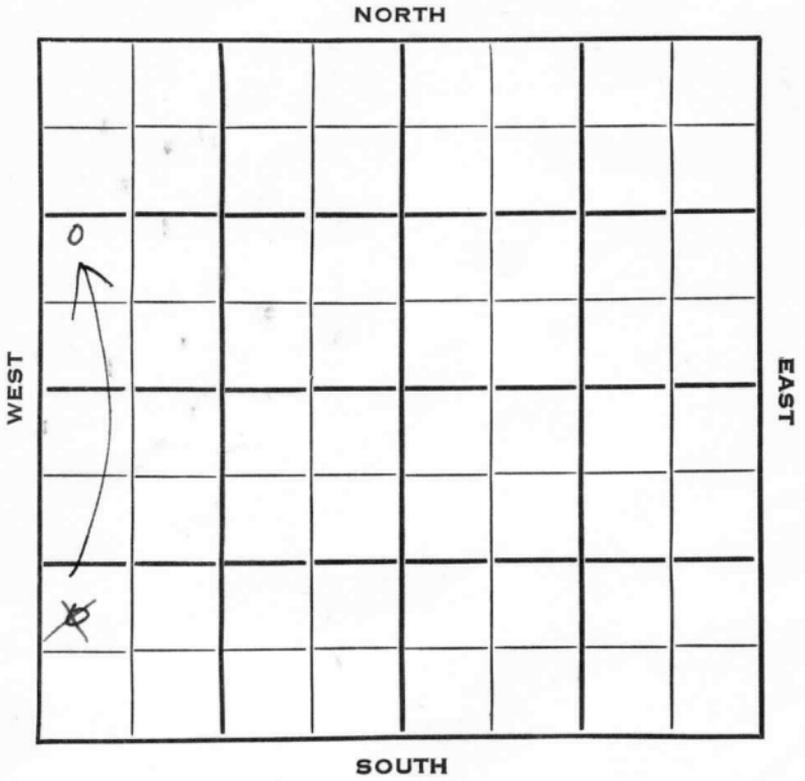

Barton
19

KANSAS
11W

27

Sec. _____ Twp. _____ R. _____

#2 Lanterman

Well No. _____ Farm _____

Alpine Oil & Royalty

Company _____

Quaker Drlg.

Contractor _____


_____ Ft. from N. Line

990 Ft. from S. Line

_____ Ft. from E. Line

330 Ft. from W. Line

~~NW SW SW~~
NW SW NW

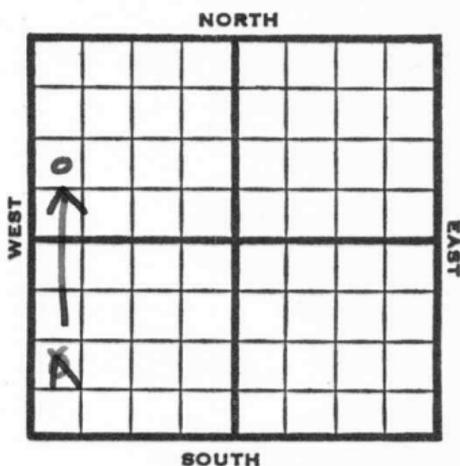

1953 Elev. 1778' REPORT

1/28 Spud 1-22-53
8" @ 227
Drlg. 2146

2/5 Heeb 2910, Br Li 3029, Lans
3048,
DST 3062-85, 20 mins., 30' HO&
GCM, 270' oil, 1290#
DST 3121-34, 1hrs., 1860' O&GCSW
920#
DST 3215-27, 1 hr., 70' SW, 880#
Arb. 3338
RTD 3340
5" @ 3339

2/12 NR

2/19 DD 3341' FU 75' oil 12 hrs.
DD 3345 1500 A no inc.
DD 3348 FU 2648' oil

2/26 POP

OVER

#2 Lanterman

1953
3/4

Spud 1-22-53

OilWell

TD 3348

8" @ 227

Heeb 2910, Br lime 3029, Lans
3048

DST 3062-85, opn 20 mins., rec.
30' ho & gcm, 270' oil, 1290#

DST 3121-34, opn 1 hr., rec.
1860' o & gcsw 920#

DST 3215-27, opn 1 hr., rec.
70' sw 880#

Arb 3338

TD 3340

5" @ 3339

DD 3341

FU 75' oil 12 hrs.

DD 3345, 1500A

DD 3348

FU 2648' oil

Comp. 25 bopd

COMPLETED

K 21223

Map No. _____ Sec. 27 Twp. 19 R. 11W

Well No. 2 Lanterman

Alpine Oil & Royalty Company

CORRECTION

Contractor

NW SW NW

SECTION PLAT

_____ Ft. from N. Line

990 Ft. from S. Line

_____ Ft. from E. Line

330 Ft. from W. Line

△ ↑			
○			

Barton County

Location _____

Rig up _____

Drilling and Remarks:

Reported
NW SWSW

RECORD

Cased _____ in., _____ ft.

Sand _____

Gas _____

Oil _____

Total Depth _____

PRODUCTION

1st 24 hrs. Nat. _____

1st 24 hrs. after shot _____

Gas _____ Cu. Ft.

Dry Hole _____

Abandoned _____

Date

JAN 28 1953

19

J. G. McGEHEE


Scout



Alpine Oil & Royalty
CORPORATION
Company
Contractor

SECTION PLAT

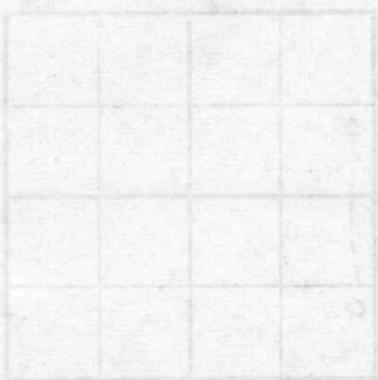

FT. from N. line


RECORD	Location
Used	Rig up
Sand	Drilling and Remarks
Gas	
Oil	
Total Depth	

PRODUCTION

Scout Cards *mm*

Land Small Map

Map Wall

37

Reported
FEB 3 1953

Date

J. G. MCGHEE

Scout

County Barton State Kansas

Sec. 27 (Blk. 19) (Sur. 11W) (Twp. 19) (Rge. 11W) Map No.

Operator Alpine Oil & Royalty

Well No. 2 Farm Lanterman

Elev. _____ Location NW SW SW

FIRST REPORT

990 Ft. From S Line SW

330 Ft. From W Line Quarter

1st. Report JAN 28 1953

Completion _____


Remarks _____

Quaker Drlg. - Contr.

Spudding Date 1-22-53

Drlg. Data _____

8" @ 227 drlg. 2146

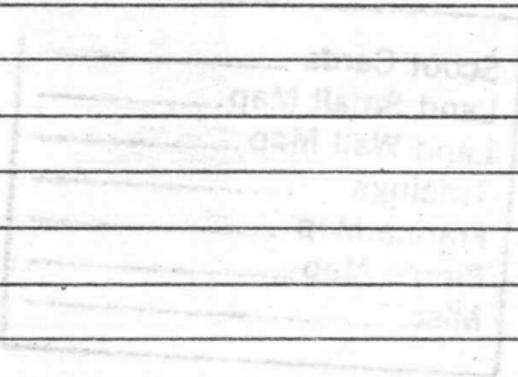

Scout Cards	42
Land Small Map	
Land Wall Map	33
Tracings	
France Map	
Pierce Map	
Misc	

FEB 1 1953

County Barton State Kansas

Sec. 27 (Blk. Twp.) 19 (Sur. Rge.) 11W Map No.

Operator Alpine Oil & Royalty

Well No. 2 Farm Lanterman

Elev. 1778 Location NW SW NW

0					

990 Ft. From S Line NW

330 Ft. From W Line Quarter

1st. Report

Completion MAR 4 1953

Remarks

Quaker Drlg. - Contr.

Spudding Date 1-22-53

Drlg. Data Oil well TD 3348

8" @ 227 Heeb. 2910 Br. lime 3029

Lans. 3048 DST 3062-85 open 20 min.

Rec. 30' ho & gcm 270' oil 1290#

DST 3121-34 open 1 hr. Rec. 1860' o &

gcsw 920# DST 3215-27 open 1 hr.

Rec. 70' sw 880# Arb. 3338 TD 3340

5" @ 3339 DD 3341 FU 75' oil 12 hr.

DD 3345 1500 A DD 3348 FU 2648' oil

Comp. 25 bopd

MAR 11 1953

Scout Cards	<i>AD</i>
Land Small Map	
Land Wall Map	<i>3</i>
Tracings	
France Map	
Pierce Map	
Misc.	

Orig. Data