
FORM 51

Barton KANSAS

Section 27 Township 19 Range 11W

Well No. #5 Lanterman

Company Alpine Oil & Royalty

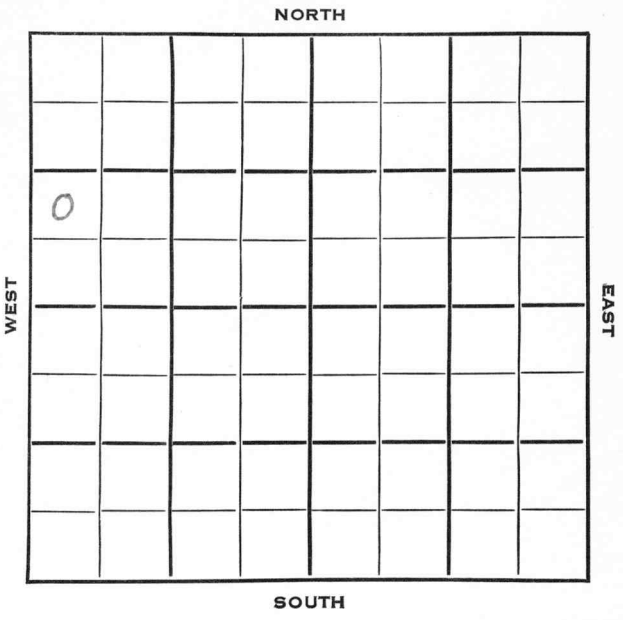

FORM 252-B
10M 10-50 PETROL

Barton

KANSAS

Sec. 27 Twp. 19 R. 11W

Well No. #5 Lanterman Farm

Alpine Oil & Royalty Company

Quaker Drlg. Contractor

Anton Pool


____ Ft. from N. Line

990 Ft. from S. Line

____ Ft. from E. Line

410 Ft. from W. Line

NW SW NW (twin well)

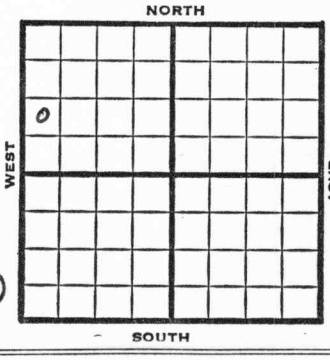

1953	Elev. 1779' REPORT
4/29	Spud 4-24-53 10" @ 208' Drlg 1535 '
5/7	Drlg 2115'
5/21	Heeb 2910' Br li 3027' Lans 3049' TD 3119' 5" @ 3115'
5/28	CO 3119 3 boph 3 hrs.
6/3	NR
6/10	Spud 4-24-53 Oil Well TD 3119' 10" @ 208' Heeb 2910', Br. Lime 3027, Lans 3049 TD 3119' 5" @ 3115' CO to 3119' 3 boph 3 hr. Comp. 25 bopd.

COMPLETED

FORM 275 FOR SALE BY KANSAS BLUE PRINT CO.


County Barton State Kansas

Sec. 27 (Blk. Twp.) 19 (Sur. Rge.) 11W Map No.

Operator Alpine Oil & Royalty

Well No. 5 Farm Lanterman

Elev. Location NW SW NW (twin well)

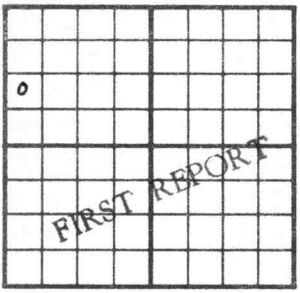

990 Ft. From S Line NW

410 Ft. From W Line Quarter

1st. Report APR 29 1953

Completion

Remarks

Quaker Drlg. - Contr.

Spudding Date 4-24-53

Drlg. Data Anton Pool

10" @ 208 drlg. 1535

J. G. McGEHEE

MAY 1 1953

Scout Cards
Land Small Map
Land Wall Map
Tracings
France Map
Pierce Map
Misc.

Drig. Data

FORM 275 FOR SALE BY KANSAS BLUE PRINT CO.


County Barton State Kansas

Sec. 27 (Blk. Twp.) 19 (Sur. Rge.) 11W Map No.

Operator Alpine Oil & Royalty

Well No. 5 Farm Lanterman

Elev. 1779 Location NW SW NW (twin well)

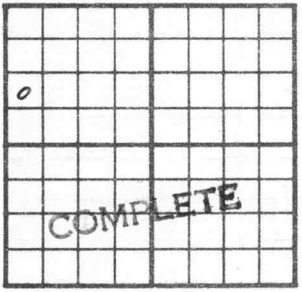

990 Ft. From S Line NW

410 Ft. From W Line Quarter

1st. Report

Completion JUN 10 1953

Remarks Anton Pool
Quaker Drlg. - Contr.

Spudding Date 4-24-53

Drlg. Data Oil well TD 3119

10" @ 208 Heeb. 2910 Br. lime 3027


Lans. 3049 TD 3119 5" @ 3115

CO to 3119 3 boph 3 hr.

Comp. 25 bopd

J. G. McGEHEE

Drlg. Data

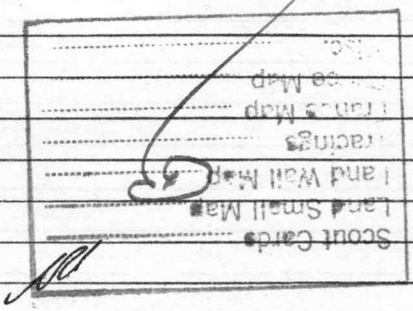

JUN 16 1953