


Section 27 Township 19 Range 11W

Well No. #6 Lanterman

Company Alpine Oil & Royalty

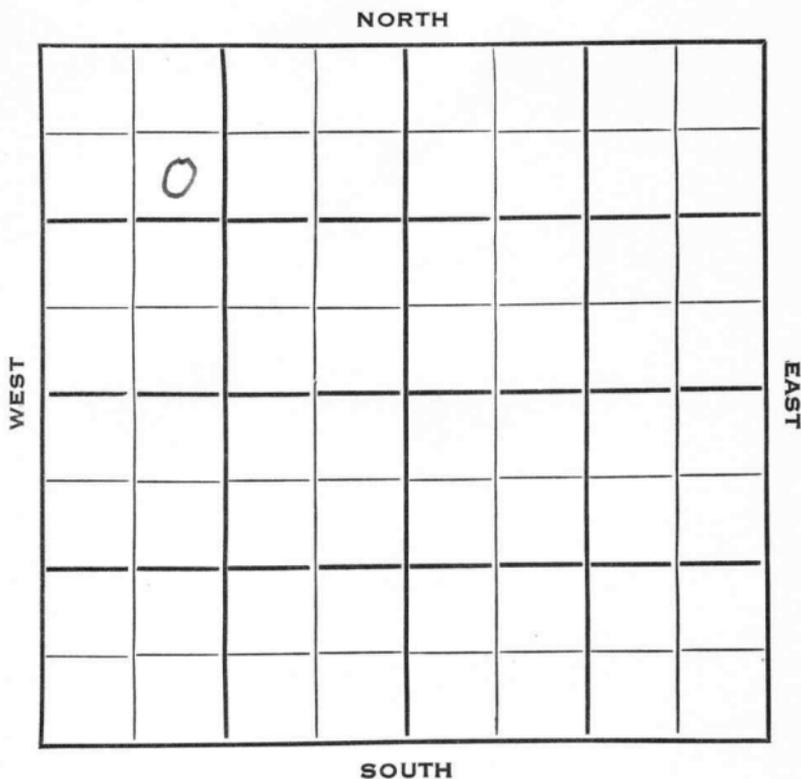

Sec. 27 Twp. 19 R. 11 WWell No. # 6 Lanterman FarmAlpine Oil & Royalty CompanyQuaker Drlg. Contractor

Anton Pool

NORTH


990 Ft. from N. Line

Ft. from S. Line

Ft. from E. Line

990 Ft. from W. Line

SE NW NW

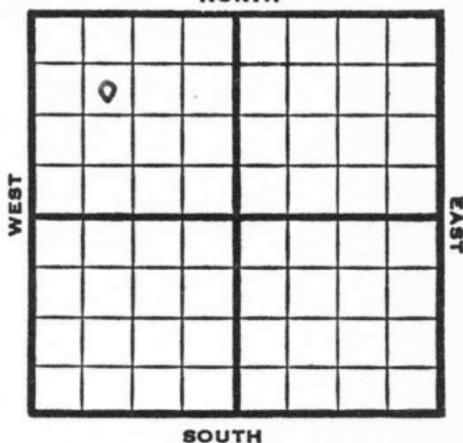

1953 Elev. 1778' REPORT

5/6 Spud 5-1-53  
10" @ 220 Anhy 540  
Drlg. 1310'

5/21 Heeb 2907' Br li 3026' Lans 3046  
DST 3047-75, 10 mins, 50' GCM 1140#  
DST 3080-3117 13 mins, 300' HO & GCM  
1200' oil

5/28 Cong 3315, Arb 3336,  
RTD 3340  
7" @ 3339'

6/3 NR  
6/10 Spud 5-1-53  
Oil Well  
TD 3345'  
10" @ 220'  
Anhy 540, Heeb 2907, Br. Lime 33026,  
Lans 3046  
DST 3047-75 open 10 min, rec 50' gcm  
1140#  
DST 3080-3117 opn 13 min, rec 300'  
ho & gcm 1200' oil Cong 3315'  
Arb 3336  
TD 3340'  
7" @ 3339'  
DD 3345 S/ 1 boph 4 hr. FU 850' oil  
8 hr.  
Comp. 25 bopd.

COMPLETED



Scout Cards	mm
Land Squall Map	
Land Wall Map	33
Tracings	
France Map	
Plane Map	
Misc.	

MAY 8 1953

Orig. Data



JUN 16 1953

Scout Cards.....	<i>ef</i>
La. & Small Map.....	
Land Wall Map.....	<i>B</i>
Tracings.....	
France Map.....	
Pierce Map.....	
Misc.....	

Drig. Data