


Section 27 Township 19 Range 11W

Well No. 1 Laterman

Company Palmer Oil Co.

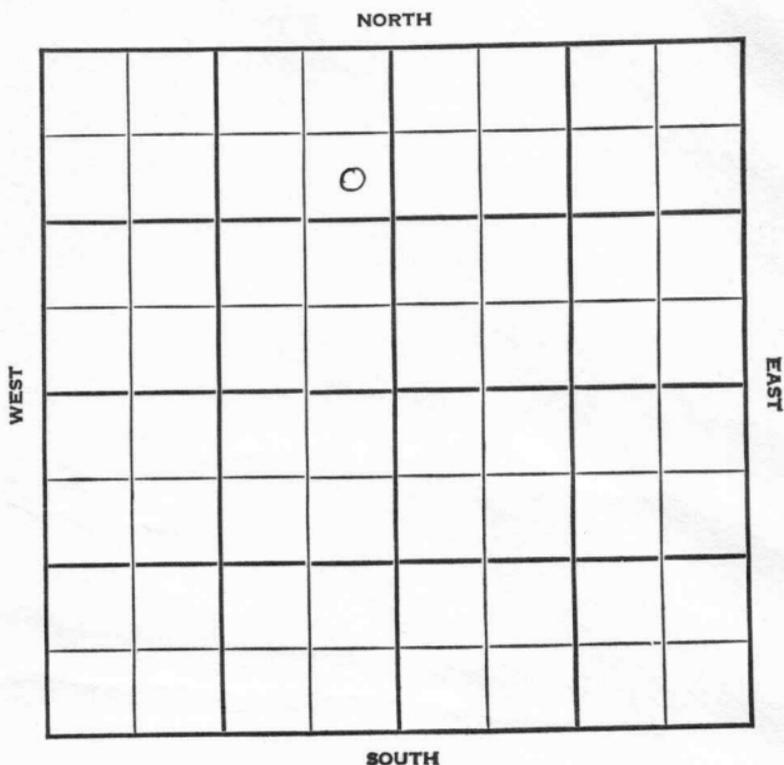



Sec. 27 Twp. 19 R. 11W

Well No. #1 Laterman Farm

Palmer Oil Company

Silica


990 Ft. from N. Line

_____ Ft. from S. Line

330 Ft. from E. Line

_____ Ft. from W. Line

SE NE NW

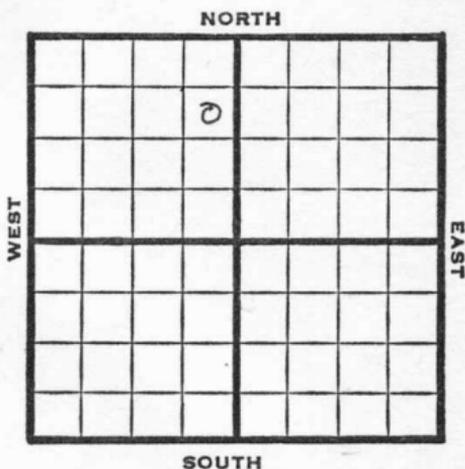

1948

Elev. -

REPORT

4/28

8" @ 212'
Drlg. 1407'

5/5

Lens. 3057'
Congl. 3321'
TD 3400 in Congl.

ABANDONED

Map No. _____ Sec. 27 Twp. 19 R. 11W

Well No. 1 Laterman

Palmer Oil Company

FIRST REPORT Contractor

SE NE NW


SECTION PLAT

990 Ft. from N. Line

_____ Ft. from S. Line

330 Ft. from E. Line

_____ Ft. from W. Line

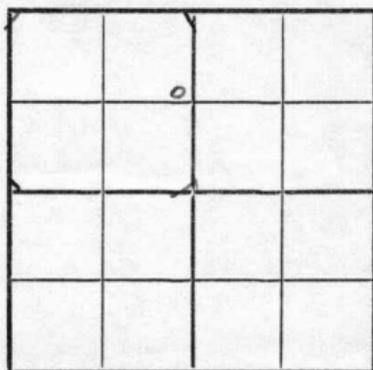

Barton County

Location _____

Rig up _____

Drilling and Remarks:

8" @ 212

drlg. 1407

RECORD

Cased _____ in., _____ ft.

Sand _____

Gas _____

Oil _____

Total Depth _____

PRODUCTION

1st 24 hrs. Nat. _____

1st 24 hrs. after shot _____

Gas _____ Cu. Ft.

Dry Hole _____

Abandoned _____

Date

APR 28 1948 19

S. J. LEWIS Scout

Map No. 46 Sec. 27 Twp. 19 R. 11W

Well No. 1 Laterman

Palmer Oil Company

ABANDONED

Contractor

SE NE NW

SECTION PLAT

990 Ft. from N. Line

_____ Ft. from S. Line

330 Ft. from E. Line

_____ Ft. from W. Line

Barton County

Location _____

Rig up _____

Drilling and Remarks:

Lease 8057
Comp 3321

RECORD

Cased _____ in., _____ ft.

Sand _____

Gas _____

Oil _____

Total Depth 3400 in Comp

PRODUCTION

1st 24 hrs. Nat. _____

1st 24 hrs. after shot _____

Gas _____ Cu. Ft.

Dry Hole _____

Abandoned _____

Date

MAY 5 1948 19

S. J. LEWIS Scout