


Barton

KANSAS

SECTION 27 TOWNSHIP 19 RANGE 11W

WELL NO. #1 Kindsvater

COMPANY Alpine Oil & Royalty

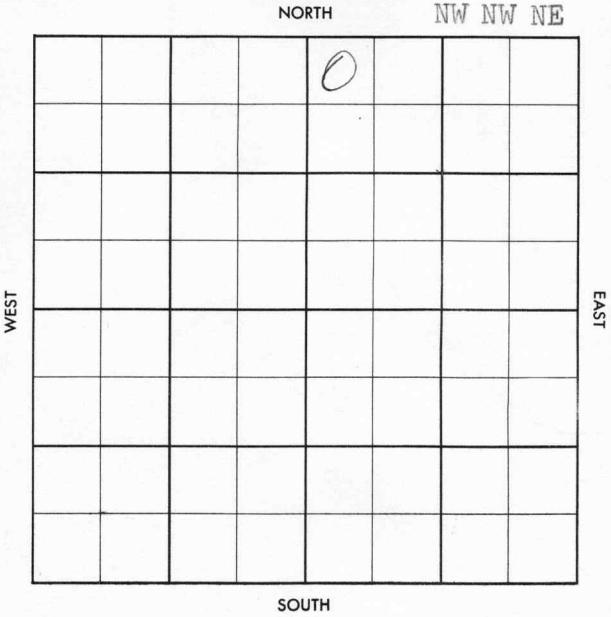

County Barton Elev. _____
 Sec. 27 Twp. 19 Rge. 11W
 Company Alpine Oil & Royalty
 Farm Name Kindsvater No. 1

TOPS	DEPTH	LOG	DATUM
Anh.			
Tp.			
H.			
Tr.			
Dg.			
Bl.			
L.			
K.C.			
B.K.C.			
Ce.			
C.			
M.			
M.			
K.			
Mz.			
Me.			
V.			
S.			
S.			
A.			
R.			
Pt.			
G.			
T.D.			

Loc. in Sec. NW NW NE
 Geol. _____
 Contr. Quaker Drlg.
 Pool _____
N Ellinwood ext

FIRST REPORT
 JUN 12 '57

Date Comm. _____
 Location _____

Co.
 Lse.
 No.
 Sec.
 T.
 R.

County Barton Elev. 1777
 Sec. 27 Twp. 19 Rge. 11W
 Company Alpine Oil & Royalty
 Farm Name Kindsvater No. 1

TOPS	DEPTH	LOG	DATUM	Loc. in Sec.
Anh.				NW NW NE
TP.				
H.	2913			
Tr.				
Dg.				
Bl.	3031			
L.	3053			Geol.
K.C.				Contr.
B.K.C.	3304			Quaker Drlg.
Ce.				
C.				Pool
M.				N Ellinwood ext
M.				
K.				
Mz.				
Me.				
V.				
S.				
S.				
A.	3331			COMPLETE
R.				
PE.				JUL 31 57
G.				
T.D.	3345			

Date Comm.

Location JUN 19 57 ✓ JUN 26 57 6-19-57
 258 235/175 DST 3058-82
 1hr 225' GIR rec 15' Md
 BHP 163 3082 DST
 3056-3122 1hr 180' 0' 6CM
 + 60' H 0' 6CM BHP 160/20"
 DST 3122-35 1hr 780' GIR rec
 50' 0' 6CM BHP 270 DST 3205
 - 90' 1hr rec 30' 0CM 163/20"
 2/20 3334 WOST JUL 10 57 JUL 12 57

CO DD 3362 FU 2300' oil
12 hrs TO ACID JUL 24 '57 1/2 FU
900' oil 12 hrs \$ 2 Boph
10 hrs POP JUL 31 '57 P. 25
Bopd no/wt.