

KANSAS

Barton

Map No. _____ Sec. 27 Twp. 19 R. 11W


Well No. 1- Schmidt Farm _____

Hilligoss Hob Company _____

NORTH

WEST

EAST

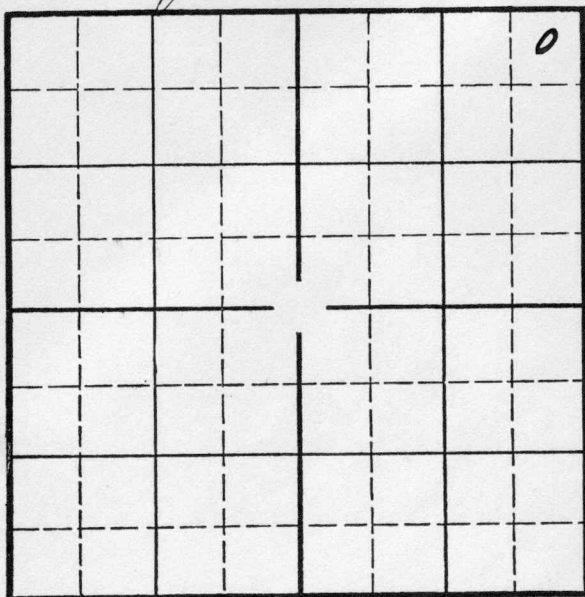

SOUTH

Location _____
Drilling Remarks _____

Rig Up _____
Drilling Remarks _____

RECORD

Cased _____ in. _____ ft.
Sand _____
Gas _____
Oil _____
Total Depth _____

PRODUCTION

1st 24 hrs. Nat. _____
1st 24 hrs. after shot _____
Gas _____ cu. ft. _____
Dry Hole _____
Abandoned _____

Map No. _____ Sec. 27 Twp. 19 R. 11W
Well No. 1- Schmidt Farm _____
Hilligoss et al Company _____


330 Ft. from N. Line

_____ Ft. from S. Line

330 Ft. from E. Line

_____ Ft. from W. Line

Elev. 1777

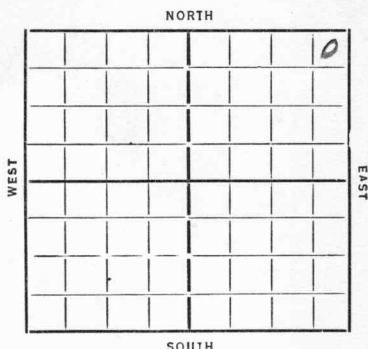

Date		REPORT
1935		
11/6		Cyprus
11/14		Pouke
11/21		11/29-12/6
12/3		B.R.
12/19		Rgn up
12/26		12/36-1/10-1/17-1/24
1/31		12" 210 WOC
2/7		Int 15" 43 Pulling 15"
2/14		Dlg 218 15" 141
2/21		12" 539 Arby 547
		Dlg 955
2/28		" 1700
3/6		" 2190 10" 1984
3/13		" 2190 10" 2062
3/20		8"- 2435 drlg. 2440
3/27		T. Topeka 2660' Drlg. 2960'
4/1		Base Kansas City 3252
		Dlg. 3265 (Tel)
4/2		Dlg. 3294 x No Siliceous (Tel)
4/4		T.D. 3307 Running 6" csg. (Tel)
4/10		Top Conglomerate 3416' Drlg. 3476'

(OVER)

4/16-

4/15 Del 3485

TD 3490

D. & A.

ABANDONED

KANSAS

Map No. 46 Sec. 27 Twp. 19 R. 11W

Well No. 1-Schmidt

Hillgoss et al Company

Contractor

FIRST REPORTS

SECTION PLAT

			0

330 Ft. from N. Line

..... Ft. from S. Line

330 Ft. from E. Line

..... Ft. from W. Line

Location.....

Rig up.....

Drilling and Remarks:

cellar

RECORD

Cased.....in.,ft.

Sand.....

Gas.....

Oil.....

Total Depth.....

PRODUCTION

1st 24 hrs. Nat.....

1st 24 hrs. after shot.....

Gas.....Cu. Ft.

Dry Hole.....

Abandoned.....

Date

11-6-35 192..... Scout

ORVAL MANNSCHRECK

Returned

Cards

Tracing

France Map

Scarborough Map

Moody Map

Scarborough Plat Book

Moody Plat Book

Map No. 46 Sec. 27 Twp. 19 R. 11WWell No. 1 KindersaterHilligoss & Co Company

Contractor

SECTION PLAT

			0

330 Ft. from N. Line

Ft. from S. Line

330 Ft. from E. Line

Ft. from W. Line

ABANDONED

Location

Rig up

Drilling and Remarks:

Sil 3485-IXA

RECORD

Cased _____ in., _____ ft.

Sand _____

Gas _____

Oil _____

Total Depth 3450

PRODUCTION

1st 24 hrs. Nat. _____

1st 24 hrs. after shot _____

Gas _____ Cu. Ft.

Dry Hole _____

Abandoned _____

Date


APR 15 1936

192

S. J. LEWIS

Scout

SECTION PLAT

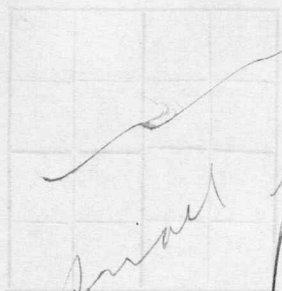

Handwritten signatures and scribbles over the grid.

Returned	<i>[Signature]</i>
Cards	<i>[Signature]</i>
Tracing	<i>[Signature]</i>
France Map	<i>[Signature]</i>
Scarborough Map	<i>[Signature]</i>
Moody Map	<i>[Signature]</i>
Scarborough Plat Book	
Moody Plat Book	

Date

Score