

KANSAS


Barton

FORM 51 IOM 12-46 PETROL

Section 27 Township 19 Range 11W

Well No. 1 Lanterman "A"

Company C. E. Ash

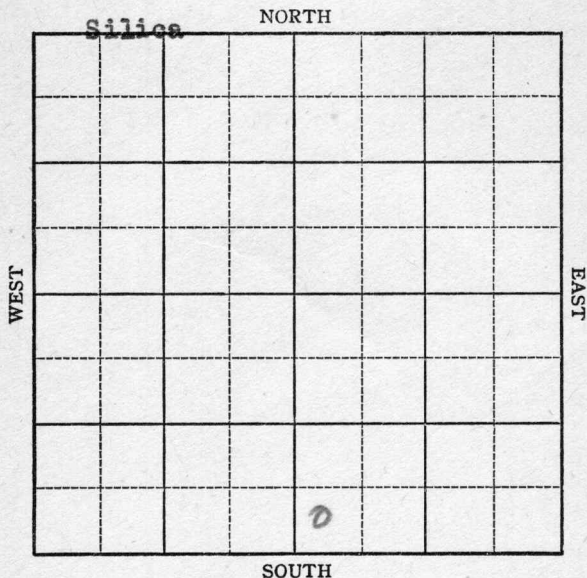

KANSAS

Barton

Sec. 27 Twp. 19 R. 11W

Well No. #1 Lanterman "A" Farm

C. E. Ash Company

Silica


 Ft. from N. Line

330 Ft. from S. Line

 Ft. from E. Line

330 Ft. from W. Line

SW SE

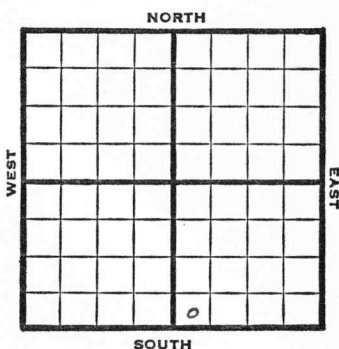

1947

Elev 1772' REPORT

8/6

RUR

8/13

8" @ 220
Drlg. 2255'

8/20

Lansing 3065'
Cong. 3342'
Drlg 3380' in Cong.
T.D. 3380'
Abandoned

ABANDONED

Kansas

Silica

Map No. _____ Sec. 27 Twp. 19 R. 11WWell No. 1 Lanterman "A"

C. E. Ash


Company

FIRST REPORT

Contractor

SW SE

SECTION PLAT

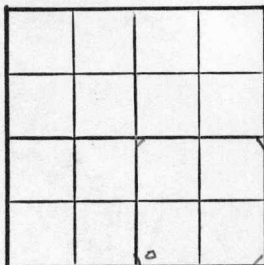

_____ Ft. from N. Line

330 _____ Ft. from S. Line

_____ Ft. from E. Line

330 _____ Ft. from W. LineBarton County

Location _____

Rig up _____

Drilling and Remarks:

RUR

RECORD

Cased _____ in., _____ ft.

Sand _____

Gas _____

Oil _____

Total Depth _____

PRODUCTION

1st 24 hrs. Nat. _____

1st 24 hrs. after shot _____

Gas _____ Cu. Ft.

Dry Hole _____

Abandoned _____

Date

AUG 6 1947 19S. J. LEWIS

Scout

Map No. 46 Sec. 27 Twp. 19 R. 11W

Well No. 1 Lanterman "A"


C. E. Ash Company

ABANDONED

Contractor

SW SE

E11772
SECTION PLAT

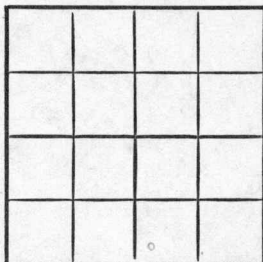

 Ft. from N. Line

330 Ft. from S. Line

 Ft. from E. Line

330 Ft. from W. Line

Barton County

Location

Rig up

Drilling and Remarks:

Lane 3065
Coag 3342
3380 in Coag

RECORD

Cased in., ft.

Sand

Gas

Oil

Total Depth 3380

PRODUCTION

1st 24 hrs. Nat.

1st 24 hrs. after shot

Gas Cu. Ft.

Dry Hole

Abandoned

Date

AUG 20 1947 19

S. J. LEWIS

Scout