


Section 27 Township 19 Range 11-W

Well No. #1 H. C. Lantermann

Company Texas

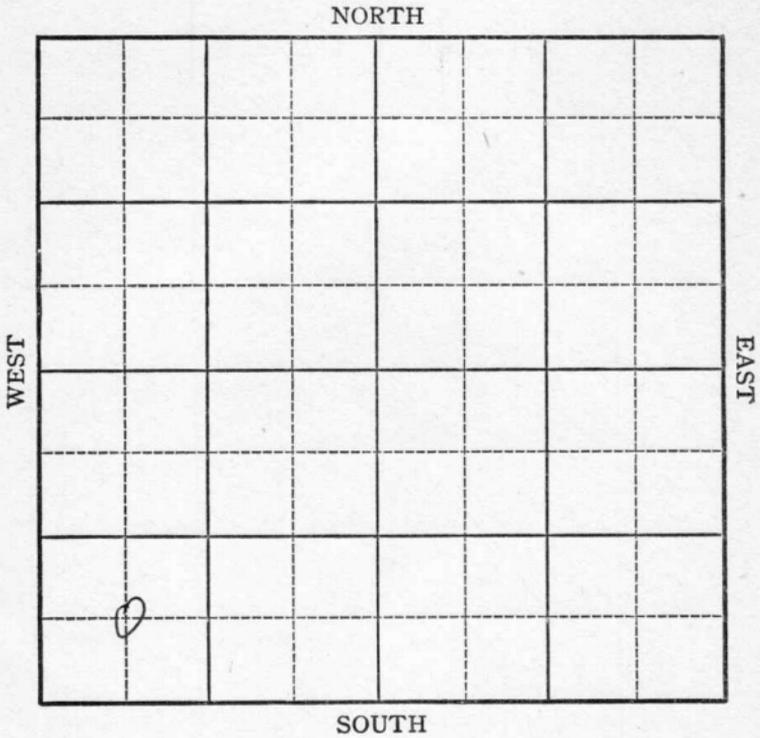

Sec. 27 Twp. 19 R. 11-W

Well No. #1 H. C. Lantermann Farm  
Texas Company


Lantermann

         Ft. from N. Line

660 Ft. from S. Line

         Ft. from E. Line

660 Ft. from W. Line

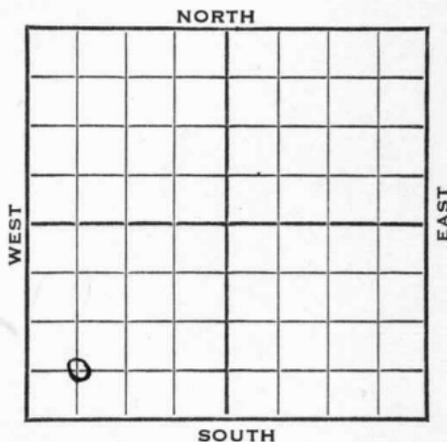

C SW SW Elev. 1777

REPORT

1943

- 1/20 Rotary.
- 1/27 "
- 2/3 10" @ 250'  
Drlg. 1480'
- 2/10 Drlg. 2675'
- 2/17 Lans 3056  
Congl 3329  
Arb 3331  
TD 3347
- 2/24 SO 5" Casing set 3333 RUST.  
TD 3348-1000 acid Testing
- 3/3 TD 3361-3000 acid Pump 26 oil  
in 12 hrs.
- 3/10 Arb. 3331  
5" @ 3333'  
T.D. 3361'  
3000 gal. acid  
Pump 26 Pot.  
Gravity 43.2

**COMPLETED**

**KANSAS**

Map No. 46 Sec. 27 Twp. 19 R. 11W

Well No. 1 H. C. Lantermann

Texas Company

Contractor

C SW SW

**SECTION PLAT**

o			

\_\_\_\_\_ Ft. from N. Line

660 Ft. from S. Line

\_\_\_\_\_ Ft. from E. Line

660 Ft. from W. Line

**LANTERMANN POOL**

Location \_\_\_\_\_

Rig up \_\_\_\_\_

Drilling and Remarks:

**Rotary**

**RECORD**

Cased \_\_\_\_\_ in., \_\_\_\_\_ ft.

Sand \_\_\_\_\_

Gas \_\_\_\_\_

Oil \_\_\_\_\_

Total Depth \_\_\_\_\_

**PRODUCTION**

1st 24 hrs. Nat. \_\_\_\_\_

1st 24 hrs. after shot \_\_\_\_\_

Gas \_\_\_\_\_ Cu. Ft.

Dry Hole \_\_\_\_\_

Abandoned \_\_\_\_\_

Date

JAN 20 1943 19

S. J. LEWIS Scout

Barton

Map No. KANSAS 6 Sec. 27 Twp. 19 R. 11W

Well No. 1 H. C. Lantermann

Texas Company

COMPLETED Contractor

C SW SW

SECTION PLAT

\_\_\_\_\_ Ft. from N. Line

660 Ft. from S. Line

\_\_\_\_\_ Ft. from E. Line

660 Ft. from W. Line

o			

LANTERMANN POOL

Location \_\_\_\_\_

Rig up \_\_\_\_\_

Drilling and Remarks:

*Ar 8333/*

*5" @ 3333*

*3000 acic*

*Pump 26 P.D.*

*43<sup>2</sup> SW*

RECORD

Cased \_\_\_\_\_ in., \_\_\_\_\_ ft.

Sand \_\_\_\_\_

Gas \_\_\_\_\_

Oil \_\_\_\_\_

Total Depth 336/

PRODUCTION

1st 24 hrs. Nat. \_\_\_\_\_

1st 24 hrs. after shot \_\_\_\_\_

Gas \_\_\_\_\_ Cu. Ft.

Dry Hole \_\_\_\_\_

Abandoned \_\_\_\_\_

Date

MAR 10 1943 19

S. J. LEWIS Scout