


Section 27 Township 19 Range 11 W

Well No. # 1 Panning

Company Alpine Oil & Royalty

NORTH

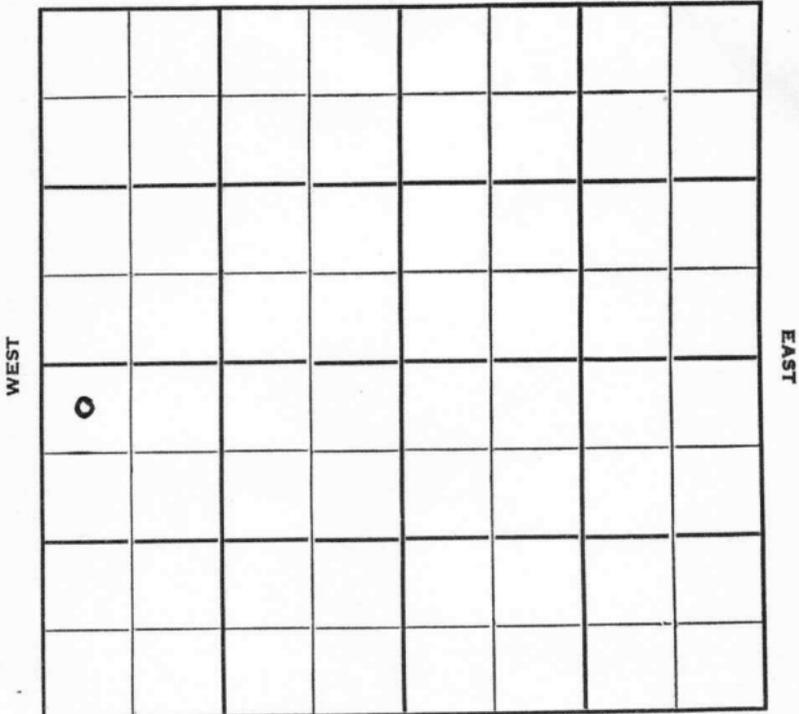

SOUTH

Sec. 27 Twp. 19 R. 11W

Well No. #1 Panning Farm

Alphine Oil & Royalty Company

Quaker Drlg. - Contr. Contractor
Anton Pool


330' Ft. from N. Line

_____ Ft. from S. Line

_____ Ft. from E. Line

330' Ft. from W. Line

NW NW SW

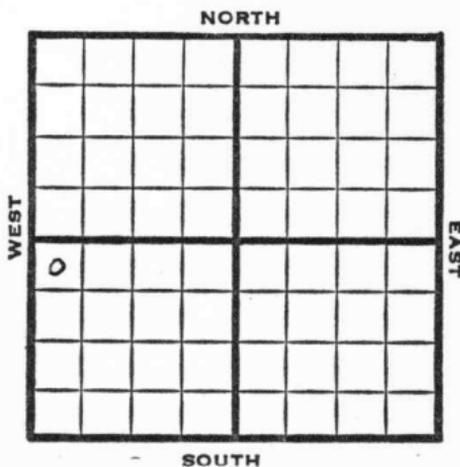

1951

Elev. 1778'

REPORT

2/7

Spud 2-5-51
8" @ 250'

3/7

Spud 2-5-51
D&A TD 3362
8" @ 250
Anhy 555-85 Heeb. 2925
Lans. 3062 Cong. 3324
Arb. 3343
DST 3347-54 opn 20 min.
Rec. 12' mud 5" @3345
TD 3362 wtr
SP 3208
Perf/3202-08 500 A 1 bo 1/5 bwph
1000 A 5 bw SSO
D&A **ABANDONED**

County Barton State Kansas

Sec. 27 (Blk.) 19 (Sur.) 11W Map No.

Operator Alpine Oil & Royalty

Well No. 1 Farm Panning

Elev. 1778 Location NW NW SW

330 Ft. From N Line SW

330 Ft. From W Line Quarter

1st. Report

Completion MAR 7 1951

Remarks Anton Pool

Quaker Drlg. - Contr.

Spudding Date 2-5-51

ABANDONED

Drlg. Data D & A TD 3362

8" @ 250 Anhy 555-85 Heeb. 2925

Lans. 3062 Cong. 3324 Arb. 3343

DST 3347-54 open 20 min. Rec. 12' mud

5" @ 3345 TD 3362 water SP 3208

Perf/ 3202-08 500 A. 1 bo 1/5 bwph

1000 A 5 bw SSO

D & A