

Barton

KANSAS

SECTION 27 TOWNSHIP 19 RANGE 11 W

WELL NO. #1 Rips

COMPANY Alpine Oil & Royalty

NORTH

				0			

WEST

EAST

SOUTH

Barton

KANSAS

SEC. 27	TWP. 19	R. 11W
------------	------------	-----------

WELL NO.

#1 Rips

FARM

COMPANY

Alpine Oil & Royalty

CONTRACTOR

Quaker Drlg.

Anton


_____ Ft. from N. Line

_____ Ft. from S. Line

_____ Ft. from E. Line

_____ Ft. from W. Line

NW SW NE

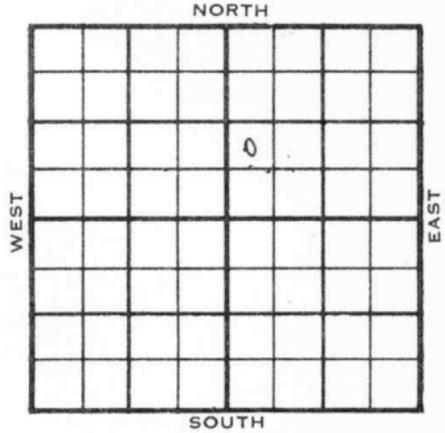

	ELEVATION	REPORT
1955	1776'	

12-28 Comm. 12-24-55
 8" @ 200
 Drlg. # 2385

1956

1-5 DST 3051-80 op 1 1/4 min. rec. 130^g gcm
 750/20"
 DST 3037-3131 op 1 hr. rec. 15' mud
 # 0#
 DST 3198-3235 op 1 hr. rec. 30' mud
 80/20"
 Dst 3348-57 op 1 hr. rec. 20' mud.
 250/20"
 D & A
 H. 2908
 BL. 3028
 L. 3048
 C. 3325
 A. 3346
 TD 3365

ABANDONED

~~Barton~~

County

Elev.

Sec.

27

Twp.

19

Rge.

11W

Company

Alpine Oil & Royalty

Farm Name

Rips

No.

1

TOPS

DEPTH

LOG

DATUM

Loc. in Sec.

Anh.

NW SW NE

Tp.

H.

Tr.

Dg.

Bl.

L.

K.C.

B.K.C.

Ce.

C.

M.

M.

K.

Mz.

Me.

V.

S.

S.

A.

R.

Pe.

G.

T.D.

Geol.

Contr.

Quaker Drlg.

Pool

Anton

DEC 28 '55

FIRST REPORT

Date Comm.

12-24-55

8" @ 200

drlg. 2385

Handwritten signature/initials

Co.

Lse.

No.

Sec.

T.

R.

County Barton Elev. 1776

Sec. 27 Twp. 19 Rge. 11W

Company Alpine Oil & Royalty

Farm Name Rips No. 1

TOPS	DEPTH	LOG	DATUM	Loc. in Sec.
Anh.				NW SW NE
Tr.				
Dg.				
Bl.	<u>3028</u>		<u>1132</u>	
L.	<u>3048</u>		<u>1272</u>	
K.C.				Geol.
B.K.C.				Contr.
Ce.				
C.	<u>3325</u>		<u>1549</u>	Quaker
M.				Pool
M.				Anton
K.				
Mz.				
Me.				
V.				
S.				
S.				
A.	<u>3346</u>		<u>1570</u>	
R.				
Pe.				
G.				
T.D.	<u>3365</u>			

ABANDONED

Date Comm. 12-24-55 JAN 5 1956

8" @ 200 DST 3051-80 open 1 1/4 min.

rec. 130' gcm 750/20" DST 3037-3121

open 1 hr. rec. 15' mud off

DST 3198-3235 open 1 hr. rec. 30' mud

80/20" DST 3348-57 open 1 hr. rec.

20' mud 250/20"

D & A