FORM 51 Barton


KANSAS

Section 27 Township 19 Range 12W

Well No. #1 Knop "B"

Company H. S. Inger

4

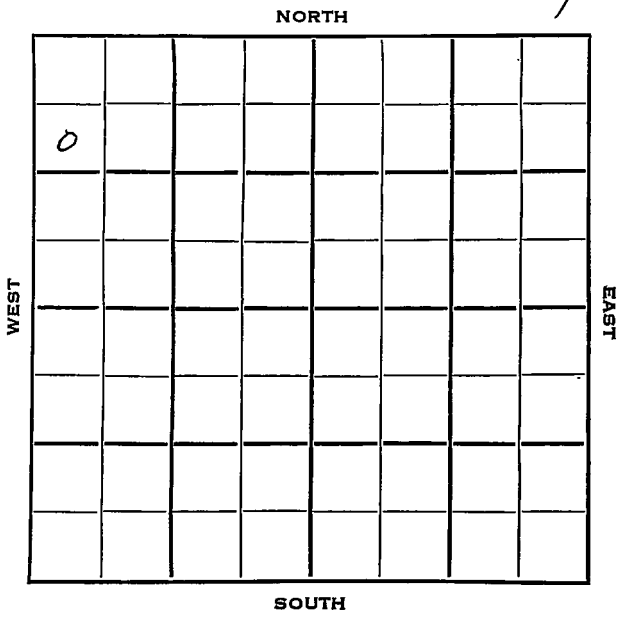

FORM 252-B
10M 8-51 TPCO.

Barton KANSAS ✓

Sec. 27 Twp. 19 R. 12W

Well No. #1 Knop "B" Farm

H. S. Inger Company

Trans-Era Contractor


990 Ft. from N. Line

Ft. from S. Line

Ft. from E. Line

330 Ft. from W. Line

SW NW NW

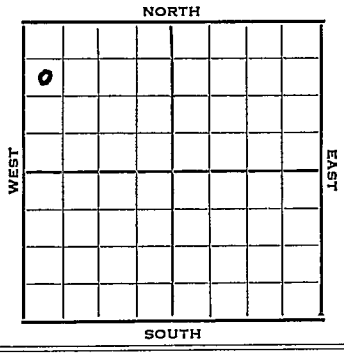

1953	Elev. 1825' REPORT
2/18	Spud 2-16-53 8" @ 180, WOC
2/26	Drlg. 2829'
3/12	Top 2765 Heeb 3016 Br li 3131' Lans 3147' Cong 3395 Arb. 3409 RTD 3413 5" @ 3410
3/19	CO 3413, 1500A
3/26	"
4/2	NR
4/9	"
4/16	"
4/23	NR
4/29	Spud 2-16-53 D & A TD 3422' 8" @ 180' Top. 2765, Heeb 3016, Br. Lime 3131, Lans 3147, Cong. 3395, Arb 3409, TD 3413 5" @ 3410' CO to 3413, 1500 A DST 3150-73 open 3/4 hr. rec 5' mud. DST 3164-3232 opn 1 hr, rec 30' mud, 490#

OVER

1953

Information brought forward

4/29 DST 3338-49 opn 1 hr, rec 15' socm
Arb. sh. 3420
DD 3422 PB 3392 14/ 3316-24 500 A
25 gw 6 goph SP 3312 2/ 3306
SP 3210 8/ 3201-03 500 A PB
3191 16/ 3172-76 SP 3164 16/ 3148-52
1000 A B/ 3 gwph
D & A

ABANDONED

FORM 275 FOR SALE BY KANSAS BLUE PRINT CO.


County Barton State Kansas

Sec. 27 (Blk. Twp.) 19 (Sur. Rge.) 12W Map No.

Operator H. S. Inger

Well No. 1 Farm Knop "B"

Elev. Location SW NW NW

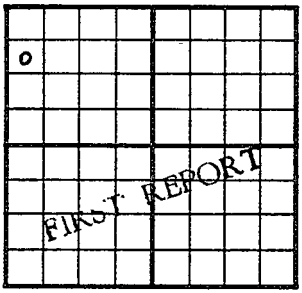

990 Ft. From N Line NW

330 Ft. From W Line Quarter

1st. Report FEB 18 1953

Completion

Remarks

Trans-Era - Contr.

Spudding Date 2-16-53

Drlg. Data

8" @ 180 WOC

J. G. McGEHEE

FEB 20 1953

Scout Cards
Land Small Map
Land Wall Map
Tracings
France Map
Pierce Map
Misc.

Drlg. Data

FORM 275 FOR SALE BY KANSAS BLUE PRINT CO.


County Barton State Kansas

Sec. 27 (Blk. Twp.) 19 (Sur. Rge.) 12W Map No.

Operator H. S. Inger etal.

Well No. 1 Farm Knop "B"

Elev. 1825 Location SW NW NW

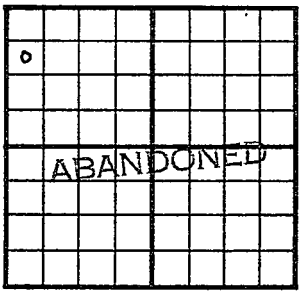

990 Ft. From N Line NW

330 Ft. From W Line Quarter

1st. Report

Completion APR 29 1953

Remarks

Trans-Era - Contr.

Spudding Date 2-16-53

Drlg. Data D & A TD 3422

8" @ 180 Top. 2765 Heeb. 3016

Br. lime 3131 Lans. 3147 Cong. 3395

Arb. 3409 TD 3413 5" @ 3410

CO to 3413 1500 A DST 3150-73

open 3/4 hr. Rec. 5' mud DST 3164-3232

open 1 hr. Rec. 30' mud 490# DST 3338-

49 open 1 hr. Rec. 15' socm Arb. sh. 7

3420 DD 3422 PB 3392 14/ 3316-24

500 A 25 gw 6 goph SP 3312 2/ 3306

SP 3210 8/ 3201-03 500 A PB 3191

16/ 3172-76 SP 3164 16/ 3148-52

1000 A B/ 3 gwph

D & A

J. G. McGEHEE

Drlg. Data

