
FORM 51 25M 8-50 WESTERN Barton KANSAS

Section 27 Township 19 Range 12 W

Well No. # 1 Johnson

Company B & R Drlg.

3

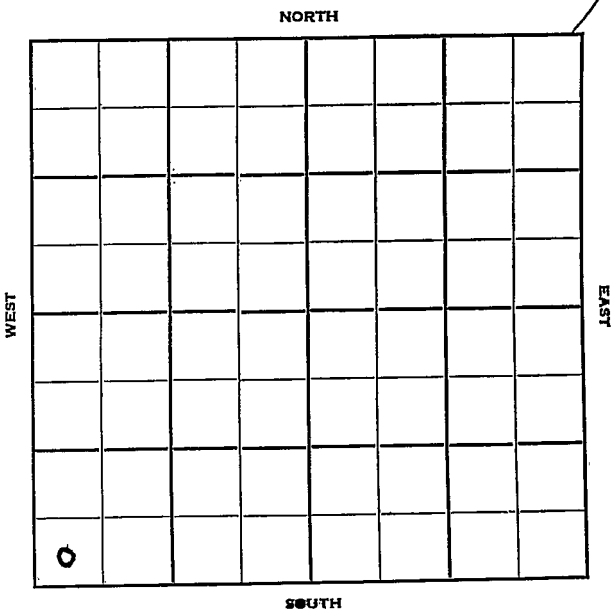

FORM 252-B
10M 10-50 PETROL

Barton KANSAS

Sec. 27 Twp. 19 R. 12W

Well No. #1 Johnson Farm

B & R Drlg. Company

Contractor

Wildcat


Ft. from N. Line

330' Ft. from S. Line

Ft. from E. Line

330' Ft. from W. Line

SW SW SW

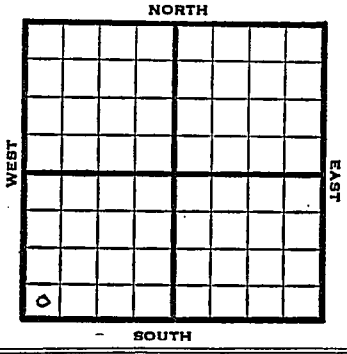

1951	Elev. 1813' REPORT
2/7	Spud 2-1-51 8" @ 173 Drlg. 1800'
3/14	Spud 2-1-51 Oil Well TD 3368' 8" @ 173' Br Lime 3101 Lans. 3120 DST 3120-46 opn 1 hr Rec. 45' mud & water Arb. 3362-65 TD 5" @ 3362 1 boph 350 A DD 3368 FU 1100' oil 15 min S/6 boph Comp. 174 bopd COMPLETED

FORM 275 FOR SALE BY KANSAS BLUE PRINT CO.

County Barton State Kansas

Sec. 27 (Blk. Twp.) 19 (Sur. Rge.) 12W Map No.

Operator B & R Drlg.

Well No. 1 Farm Johnson

Elev. 1813 Location SW SW SW

FIRST REPORT

O

330 Ft. From S Line SW

330 Ft. From W Line Quarter

1st. Report FEB 7 1951

Completion

Remarks

Spudding Date 2-1-51

Drlg. Data Wildcat

8" @ 173 drlg. 1800

J. E. TVRA

FORM 275 FOR SALE BY KANSAS BLUE PRINT CO.


County Barton State Kansas

Sec. 27 (Blk. Twp.) 19 (Sur. Rge.) 12W Map No.

Operator B & R Drlg.

Well No. 1 Farm Johnson

Elev. 1813 Location SW SW SW

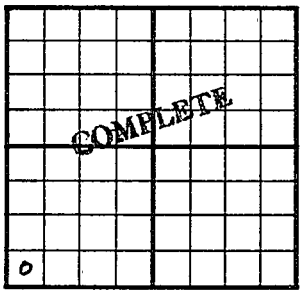

330 Ft. From S Line SW

330 Ft. From W Line Quarter

1st. Report

Completion MAR 1 4 1951

Remarks Wildcat

Spudding Date 2-1-51

Drlg. Data Oil well TD 3368

8" @ 173 Heeb. 2983 Br. lime 3101

Lans. 3120 DST 3120-46 open 1 hr.

Rec. 45' mud & water Arb. 3362-65 TD

5" @ 3362 ½ boph 350 A DD 3368

FU 1100' oil 15 min. S/ 6 boph

Comp. 174 bopd

J. E. TYRA