FORM 51 25M 8-50 WESTERN


Barton KANSAS

Section 27 Township 19 Range 12W

Well No. #3 Johnson "A"

Company Trans-Era

13

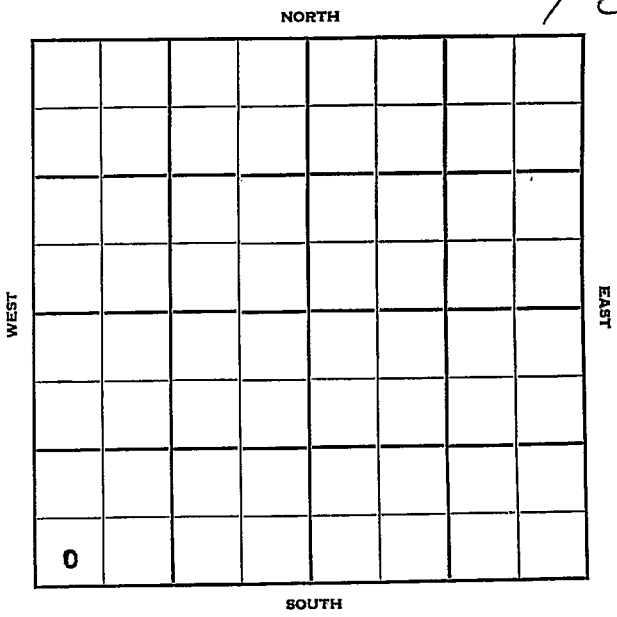

FORM 252-B

Barton KANSAS

Sec. 27 Twp. 19 R. 12W

Well No. #3 Johnson "A" Farm

Trans-Era Company

Trans-Era Contractor

Ft. Zarah Pool


____ Ft. from N. Line

280 Ft. from S. Line

____ Ft. from E. Line

330 Ft. from W. Line

SW SW SW (TWIN WELL)

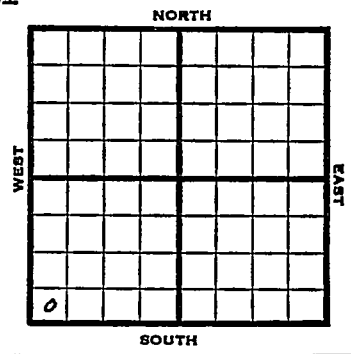

1953	Elev. 1831' REPORT
6/3	MIR
6/10	8" @ 98' Anhy 625' Drlg 2650'
6/24	RTD 3368 5" @ 3365'
7/1	N.R.
7/8	"
7/22	"
7/29	"
8/5	Spud 6-3-53 Oil Well TD 3368' 8" @ 98' Anhy 625, Lans 3117, DST 3178-3212 opn ½ hr, rec 210' mud & geo 1000# Arb 3364 DST 3326-51 opn 1½ hr, rec 35' ocm 0# TD 3368' 5" @ 3365' CO to 3327' 24/ 3200-07 1000 A S/ 5½ boph Comp. 48 bopd. COMPLETED

FORM 275 FOR SALE BY KANSAS BLUE PRINT CO.


County Barton State Kansas

Sec. 27 (Blk. Twp.) 19 (Sur. Rge.) 12W Map No.

Operator Trans-Era

Well No. 3 Farm Johnson "A"

Elev. Location SW SW SW (twin well)

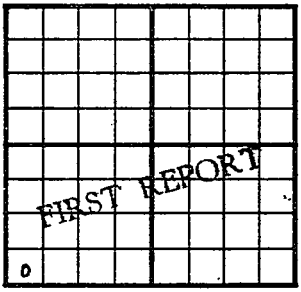

280 Ft. From S Line SW

330 Ft. From W Line Quarter

1st. Report JUN 3 1953

Completion

Remarks

Trans-Era - Contr.

Spudding Date

Drlg. Data Ft. Zarah Pool

M I R

J. G. McGEHEE

FORM 275 FOR SALE BY KANSAS BLUE PRINT CO.


County Barton State Kansas

Sec. 27 (Blk. Twp.) 19 (Sur. Rge.) 12W Map No.

Operator Trans-Era

Well No. 3 Farm Johnson "A"

Elev. 1813 Location SW SW SW (twin well)

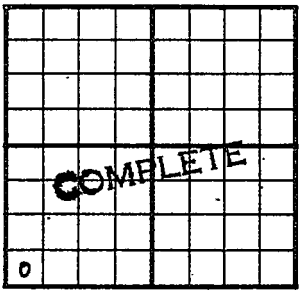

380 Ft. From S Line SW

330 Ft. From W Line Quarter

1st. Report

Completion 4UG 5 1953

Remarks Ft. Zarah Pool

Trans-Era - Contr.

Spudding Date 6-3-53

Drlg. Data Oil well TD 3368

8" @ 98 Anhy 625 Lans. 3117

DST 3178-3212 open ½ hr. Rec. 210'

mud & gco 1000# Arb. 3364 DST 3326-51

open 1½ hr. Rec. 35' ocm 0# TD 3368

5" @ 3365 CO to 3327 24/ 3200-07

1000 A S/ 5½ boph Comp. 48 bopd

J. G. McGEHEE