


KANSAS

Section 27 Township 19 Range 10 W

Well No. #1 Dipple "Z"

Company J C Dozier et al;
Silica Pool

NORTH

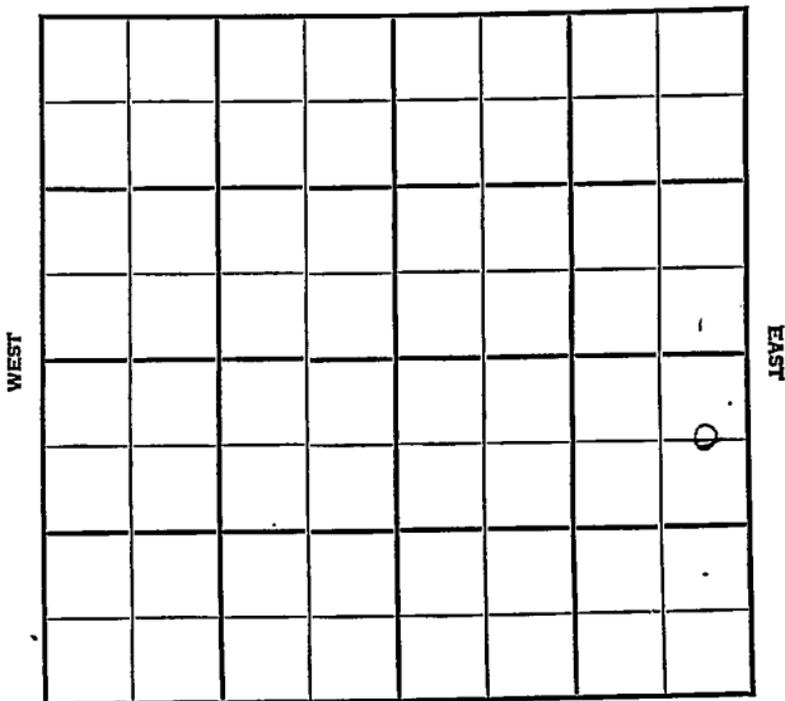

SOUTH



Sec. 27 **KANSAS** Twp. 19 R. 10^W

Well No. #1 Dipple "2" Farm

J. C. Dozier et al Company
Silica Pool


660' Ft. from N. Line

 Ft. from S. Line

330' Ft. from E. Line

 Ft. from W. Line

C E L N E S E

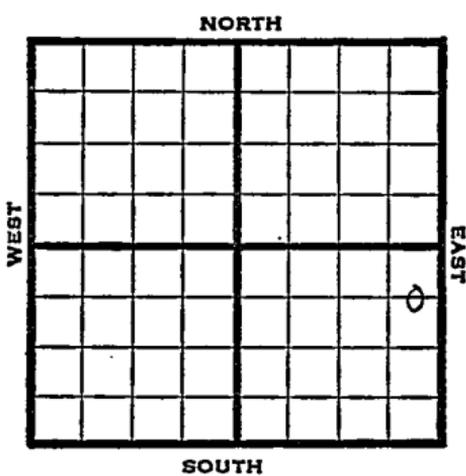

1948

Elev. 1762' REPORT

5/26

RUR

6/1

8" @ 220'
Drlg. 2360'

6/9

Lans. 2956'
Cong. 3720'
Arb. 3297'
TD 3330'
Abd.

ABANDONED

Map No. _____ Sec. 27 Twp. 19 R. 10W

Well No. 1 Dipple "Z"

J. C. Dozier et al. Company

FIRST REPORT Contractor

C E L N E S E


SECTION PLAT

660 Ft. from N. Line

_____ Ft. from S. Line

330 Ft. from E. Line

_____ Ft. from W. Line

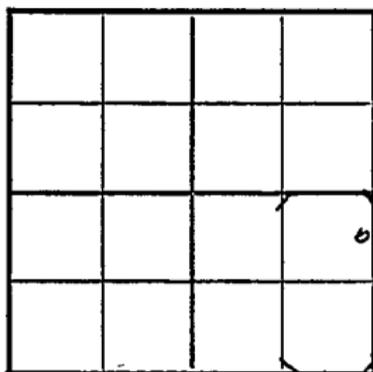

Rice County

Location _____

Rig up _____

Drilling and Remarks:

R U R

RECORD

Cased _____ in., _____ ft.

Sand _____

Gas _____

Oil _____

Total Depth _____

PRODUCTION

1st 24 hrs. Nat. _____

1st 24 hrs. after shot _____

Gas _____ Cu. Ft.

Dry Hole _____

Abandoned _____

Date

MAY 26 1948

19

S. J. LEWIS Scout

1880

I D







Misc. Small Maps	
Cards	<i>[Signature]</i>
Tracing	<i>[Signature]</i>
France Map	<i>[Signature]</i>
Scarborough Map	<i>[Signature]</i>
Pierce Map	<i>[Signature]</i>
Geological Dept.	
Pierce Plat Book	








Map No. 46 Sec. 27 Twp. 19 R. 10W

Well No. 1 Dipple "Z"

J. C. Dozier et al. Company

ABANDONED

Contractor

C E L N E S E

E. 1762

SECTION PLAT

660 Ft. from N. Line

 Ft. from S. Line

330 Ft. from E. Line

 Ft. from W. Line

			δ

Rice County

Location

Rig up

Drilling and Remarks:

Lane 2956
Cong 3720
Per 3297

RECORD

Cased in., ft.

Sand

Gas

Oil

Total Depth 3330

PRODUCTION

1st 24 hrs. Nat.

1st 24 hrs. after shot

Gas Cu. Ft.

Dry Hole

Abandoned

Date


JUN 9 1948 19

S. J. LEWIS Scout


A A DORIED

SECTION PLAN

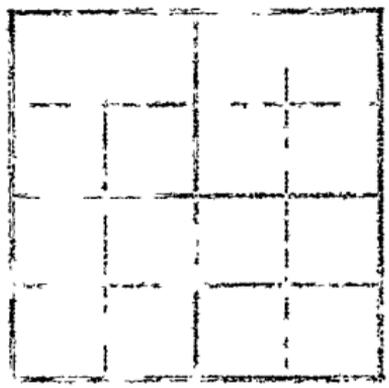

From N. line
 From E. line
 From W. line
 From S. line

SECTION



- Misc. Small Maps
- Cards
- Tracing
- France Map
- Scarborough Map
- Pierce Map
- Geological Dept
- Pierce Plat Book

Date

