

Rice

KANSAS

27

19

10W

SECTION \_\_\_\_\_ TOWNSHIP \_\_\_\_\_ RANGE \_\_\_\_\_

#2 Roelfs


WELL NO. \_\_\_\_\_

S. Lebow (Was Central)

COMPANY \_\_\_\_\_

NORTH

C S/2 NW NE

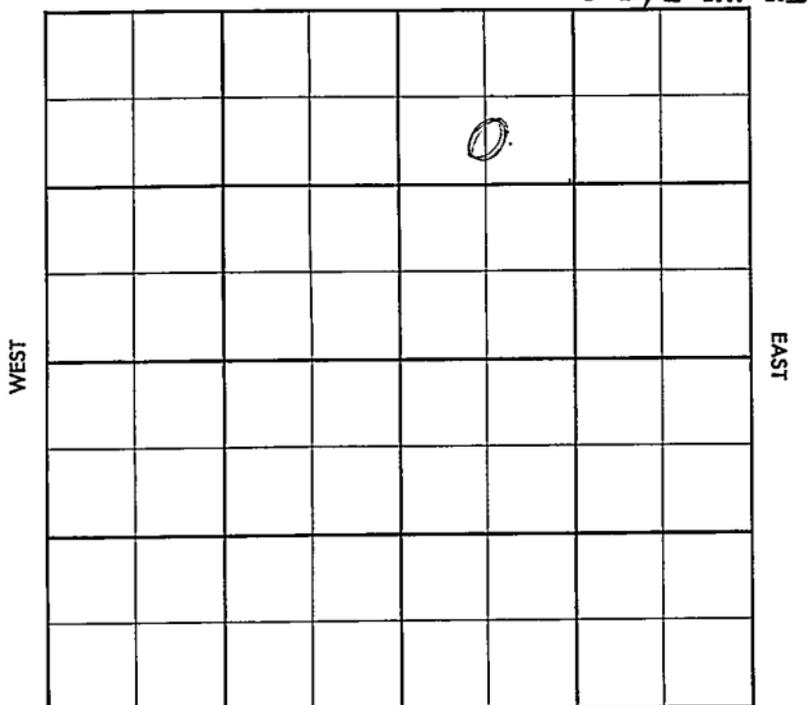

SOUTH

County Rice Elev. \_\_\_\_\_  
 Sec. 27 Twp. 19 Rge. 10W  
 Company S. Lebow (was Central)  
 FarmName Roelfs No. 2

TOPS	DEPTH	LOG	DATUM
Anh.			
Tp.			
H.			
Tr.			
Dg.			
Bl.			
L.			
K.C.			
B.K.C.			
Ce.			
C.			
M.			
M.			
K.			
Mz.			
Mo.			
V.			
S.			
S.			
A.			
R.			
Pe.			
G.			
T.D.			

Loc. in Sec. C S/2 NW NE

Geol. Powers

Contr. Sierra Drlg.

Pool Chase-Silica

MAR 6 1957		
FIRST REPORT		

Date Comm. 3-2-57  
8" @ 215/135, Drlg. 2140

12

Co.

Use

FNo.

Sec.

T.

R.

County Rice Elev. 1750 Co. \_\_\_\_\_  
 Sec. 27 Twp. 19 Rge. 10W  
 Company S. Lebow (was Central)  
 Farm Name Roelfs No. 2

TOPS	DEPTH	LOG	DATUM	Loc. in Sec.
Anh.				C S/2 NW NE
Tp.	2558			
H.	2799			
Tr.				
Dg.				
Bl.	2921			
L.	2945			Geol. Powers
K.C.				Contr.
B.K.C.				Sierra Drlg.
Ce.				
C.	3255			Pool
M.				Chase-Silica
M.				
K.				
Mz.				
Mo.				
V.				
S.				
S.				
A.	3257			
R.				
PE.				
G.				
TD.	3289			

COMPLETE  
MAY 1 57

Date Comm. 3-2-57  
8" @ 215/135, Drlg. 2140, DST 3025 -  
39 (15) rec 32' SGLM + the oil  
BHP 340(30) DST 3123 -44 (90)  
rec 60' SGLWM BHP 510(20)  
DST 3259-65 (120) rec 20' Acid + wtr/cm  
1 c 3266 -89  
DST 3265-89 (60) 420' SIP rec  
65' O+GCM 120' HO+GCM BHP 690  
(20) TD 3289 5' 3266 /  
 M 107 57 NO. 57 AT 057 APR 17 57 APR 24 57

CO 3289 A & 1 Bot + 1 Bwpd  
TER POP MAY 1 57 EST P.  
20 Bopd + 20 Bwpd.