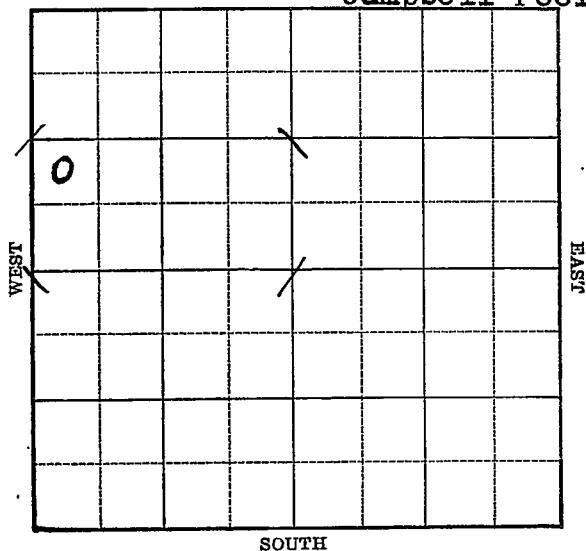


Section 27 Township 19 Range 9-WWell No. 1 CampbellCompany OKAN Drilling
~~Clark Nye & H. Bennett~~NORTH Campbell Pool

Rice

KANSAS

Map No. 49 Sec. 27 Twp. 19 R. 9WWell No. 1 CampbellClark Nye & H. Bennett Company

Contractor


FIRST REPORT

NW SW NW

 Ft. from N. Line990 Ft. from S. Line Ft. from E. Line330 Ft. from W. Line

CAMPBELL POOL

SECTION PLAT

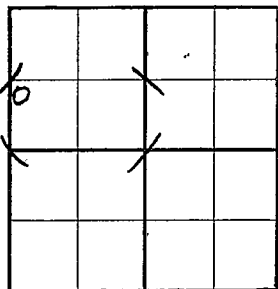Location XRig up

Drilling and Remarks:

RECORD

Cased in., ft.Sand Gas Oil Total Depth

PRODUCTION

1st 24 hrs. Nat. 1st 24 hrs. after shot Gas Cu. Ft.Dry Hole Abandoned

Date

H. D. Hatfield

FEB 8 - 1939

Scout

Rice KANSAS

Map No. 49 Sec. 77 Twp. 19 R. 9 WWell No. 1 - CampbellOkan Dlg Company(Company Name For Nye & Bennett et al) ~~Contractor~~SW SW NW

SECTION PLAT

10			

____ Ft. from ~~Top~~ Line990 Ft. from S. Line

____ Ft. from E. Line

330 Ft. from W. Line

CORRECTION

CORRECTION

Location _____

Rig up _____

Drilling and Remarks:

1st reported asNye & Bennett -Name corrected toOkan Dlg CoDrill site N²S²NW

RECORD

Cased _____ in., _____ ft.

Sand _____

Gas _____

Oil _____

Total Depth _____

PRODUCTION

1st 24 hrs. Nat. _____

1st 24 hrs. after shot _____

Gas _____ Cu. Ft.

Dry Hole _____

Abandoned _____

Date

FEB 15 1939

19

E. D. Hatfield

Scout

Rice

KANSAS

Map No. 49 Sec. 27 Twp. 19 R. 9WWell No. 1 CampbellOkan Drilling Company

Contractor

ABANDONED

NW SW NW

Ft. from N. Line

990 Ft. from S. Line

Ft. from E. Line

330 Ft. from W. Line

CAMPBELL POOL

SECTION PLAT

0			

Location _____

Rig up _____

Drilling and Remarks:

No showsD & A

RECORD

Cased _____ in., _____ ft.

Sand Arb 3216

Gas _____

Oil _____

Total Depth 3256

PRODUCTION

1st 24 hrs. Nat. _____

1st 24 hrs. after shot _____

Gas _____ Cu. Ft.

Dry Hole _____

Abandoned _____

Date

MAR 9 - 1939 19 H. D. Hatfield Scout