

Rice


KANSAS

Form 51-5M-7-39-Palace

Section 27 Township 19 Range 9-W

Well No. #3 Sledd


Company Skelly

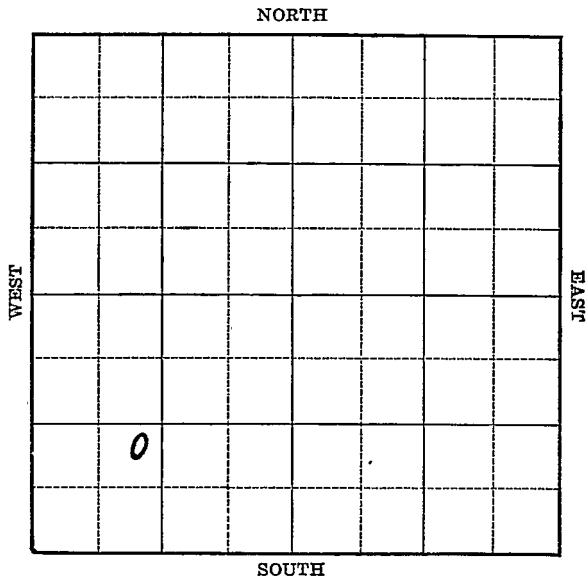

KANSAS Rice

Sec. 27 Twp. 19 R. 9-WWell No. #3 Sled FarmSkelly Company

(Campbell)

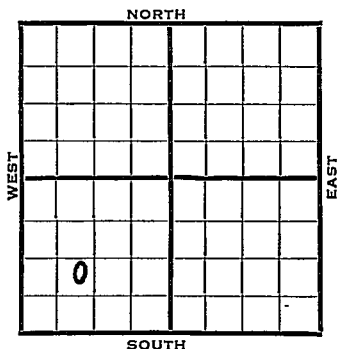 Ft. from N. Line1047 Ft. from S. Line Ft. from E. Line1047 Ft. from W. Line

Elev. 1684

1940	REPORT
4/3	10 $\frac{3}{4}$ " - 220' WOC.
4/12	Drlg. 2100'
4/18	Lans. 2860' Arb. 3192-95' T.D.
	Run 5".
4/24	Arb. 3184'
	5" - 3193'
	T.D. 3212'
	2000 acid.
	Echometer potential 1002 bbls.

COMPLETED

Map No. 49 Sec. 27 Twp. 19 R. 9WWell No. 3 SleddSkelly

Company

FIRST REPORT

Contractor

NE SW SW

Ft. from N. Line

1047 Ft. from S. Line

Ft. from E. Line

1047 Ft. from W. Line

SECTION PLAT

o			

CAMPBELL POOL

Location

Rig up

Drilling and Remarks:

10 $\frac{3}{4}$ " - 220

WOC

RECORD

Cased _____ in., _____ ft.

Sand _____

Gas _____

Oil _____

Total Depth _____

PRODUCTION

1st 24 hrs. Nat. _____

1st 24 hrs. after shot _____

Gas _____ Cu. Ft.

Dry Hole _____

Abandoned _____

Date

APR 2 1919

S. J. LEWIS Scout

Map No. 49 Sec. 27 Twp. 19 R. 9WWell No. 3 SleddSkelly

Company

Contractor

COMPLETED

NE SW SW

 Ft. from N. Line1047 Ft. from S. Line Ft. from E. Line1047 Ft. from W. Line

SECTION PLAT

0			

CAMPBELL POOL

Location Rig up

Drilling and Remarks:

*Per 83184**5" @ 8193**2000 acid**Echometer Log**1002*

RECORD

Cased in., ft.Sand Gas Oil Total Depth 3212

PRODUCTION

1st 24 hrs. Nat. 1st 24 hrs. after shot Gas Cu. Ft.Dry Hole Abandoned

Date

APR 24 1940 19S. J. LEWIS Scout