

Rice


KANSAS

Section 27 Township 19 Range 9-W

Well No. 2 Sledd

Company Skelly

NORTH Campbell Pool

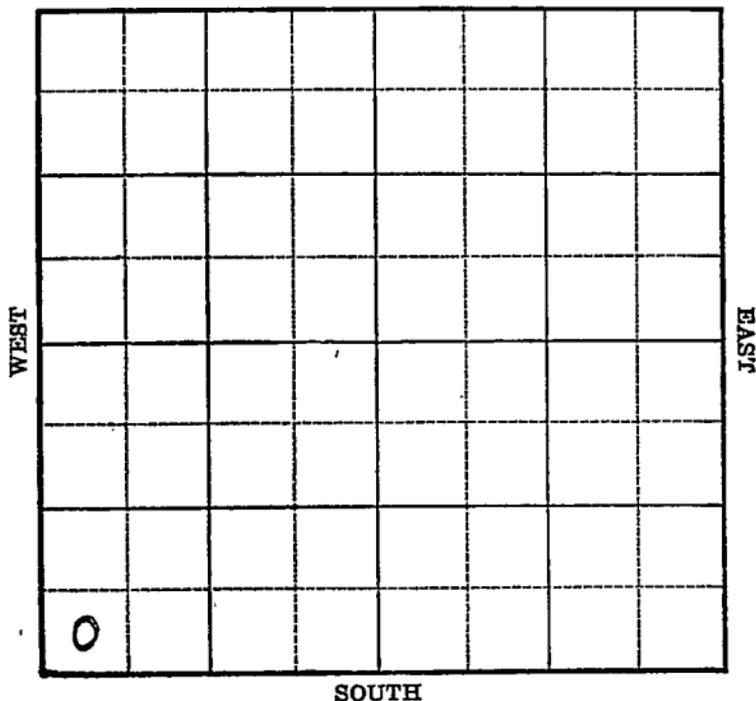

Sec. 27 Twp. 19 R. 9-W

Well No. #2 Slead Farm _____

Skelly Company _____

(Campbell)


_____ Ft. from N. Line

330 Ft. from S. Line

_____ Ft. from E. Line

330 Ft. from W. Line

Elev. 1683

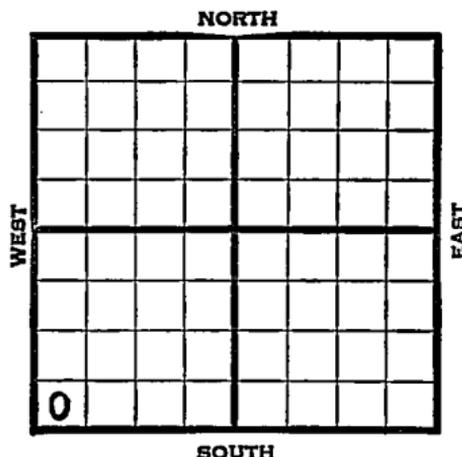

1939	REPORT
5/17	B.R.R.
5/26	10" - 207' Drlg. 300'
6/7	Drlg. - 2850'
6/8	Lansing 2859' S.O. 2930-42'
	Arb. 3173'
	Sat. 3175 T.D. 7" @ 3174'
	-
6/14	Arb. 3173'
	7" - 3174'
	2000 acid.
	T.D. 3207'
	Pump 486 bbls. 8 hours.
	Potential 1459 bbls.
	COMPLETED

