


Section 27 Township 19 Range 9W

Well No. #1 Sledd

Company Skelly

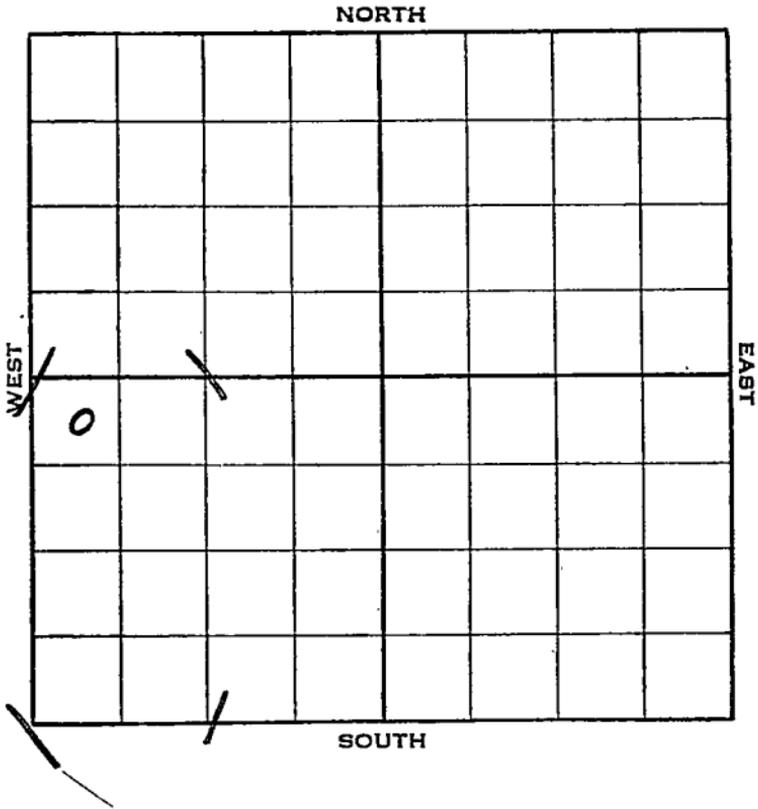

Rice

Map No. 49 Sec. 27 Twp. 19 R. 9WWell No. 1 SleddSkelly

Company

Contractor

FIRST REPORT

NW SW

330 Ft. from N. Line

_____ Ft. from S. Line

_____ Ft. from E. Line

330 Ft. from W. Line

SECTION PLAT

0			

Location _____

Rig up _____

Drilling and Remarks:

BRR

RECORD

Cased _____ in., _____ ft.

Sand _____

Gas _____

Oil _____

Total Depth _____

PRODUCTION

1st 24 hrs. Nat. _____

1st 24 hrs. after shot _____

Gas _____ Cu. Ft.

Dry Hole _____

Abandoned _____

Date

AUG 3 - 1938

19

H. D. Hatfield

Scout

Rice

KANSAS

Map No. 49 Sec. 27 Twp. 19 R. 9W

Well No. 1 Sledd

Skelly Company

Contractor

COMPLETED

SECTION PLAT

NW SW

330 Ft. from N. Line

_____ Ft. from S. Line

_____ Ft. from E. Line

330 Ft. from W. Line

0			

Location _____

Rig up _____

Drilling and Remarks:

500 + 1500 acid

pot. 1043

Rump

RECORD

Cased _____ in _____ ft.

Sand *tubular 3188*

Gas _____

Oil _____

Total Depth *3217 1/2*

PRODUCTION

1st 24 hrs. Nat. _____

1st 24 hrs. after shot _____

Gas _____ Cu. Ft.

Dry Hole _____

Abandoned _____

Date

SEP 7 - 1938 19

ORVAL MANNSCHRECK Scout