


Section 27 Township 19 Range 2W
 Well No. #5 Anderson "B"
 Company National Assoc. Pet.

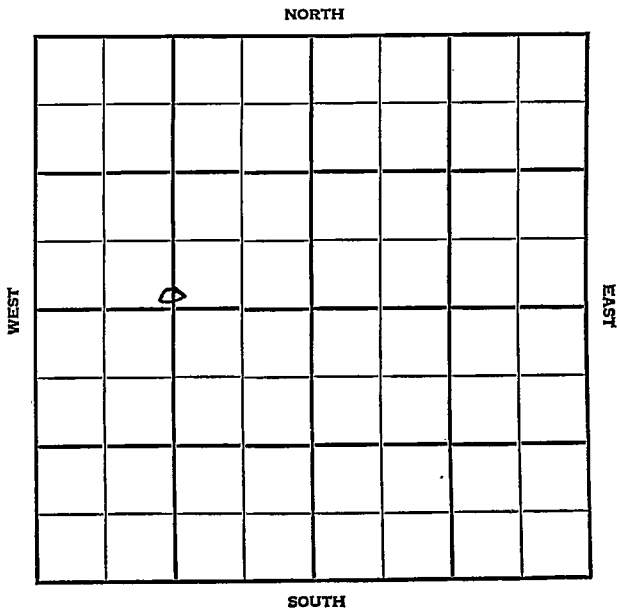

McPherson KANSAS

SEC.	TWP.	R.
27	19	2 W

WELL NO. _____

5 Anderson "B" FARM

COMPANY _____

National Assoc. Pet. _____

CONTRACTOR _____


Lively

_____ Ft. from N. Line

_____ Ft. from S. Line

_____ Ft. from E. Line

_____ Ft. from W. Line

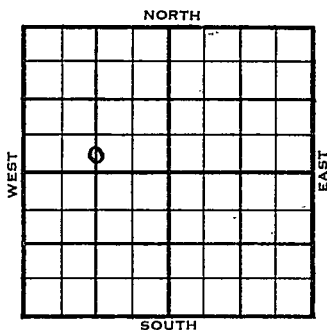

C S $\frac{1}{2}$ S $\frac{1}{2}$ NW


	ELEVATION	REPORT
1955	1553'	
5/25	Spud 4-25-55 8" @ 154 w/75 5" @ 2967 CO to 2973' S/$\frac{1}{2}$ BOPH $\frac{1}{2}$ BW frac. S/3 BO 2 BWPH Comp. 25 BOPD 30 BW Tops: Kansas City 2334', Miss 2965' TD 2973'	FIRST REPORT ↓ COMPLETED

FIRST REPORT
COMPLETEDCounty McPherson Elev. 1553Sec. 27 Twp. 19 Rge. 2WCompany National Assoc. Pet.Farm Name Anderson "B" No. 5

TOPS	DEPTH	DATUM
Cim. Anhydrite		
Ft. Riley		
Howard		
Topeka		
Heebner Sh.		
Toronto ls.		
Brown Lime		
Lansing		
Kans. City	2334	781
B. K. C.		
Congl.		
Miss.	2965	1412
Kinderhook		
Misener		
Hunton		
Sylv. Maquo		
Viola		
Simpson		
Smp.		
Gorham		
Arbuckle		
Basal Sand		
Pre. Cam.	2973	
T. D.		

Loc. in Section C S $\frac{1}{2}$ S $\frac{1}{2}$ NW

Drig. Contr.

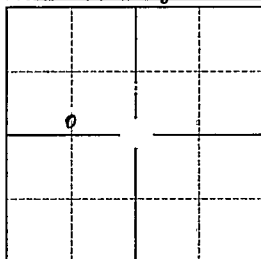Pool Lively

Date Comm.

Date Comp.

MAY 25 '55

Spud 4-25-55 8" @ 154 w/ 75

5" @ 2967 CO to 2973 S/ $\frac{1}{2}$ boph $\frac{1}{2}$ bw

frac S/ 3' to 2 bwph.

Comp. 25 bopd 30 bw