


Section 27 Township 19 Range 2W
Well No. 4 Rischell "B"
Company National Assoc. Petr.

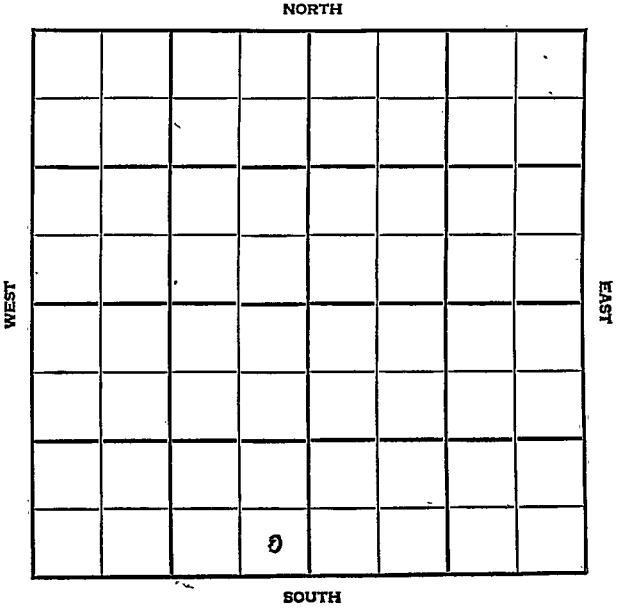

McPherson KANSAS

SEC.	TWP.	R.
27	19	2W

WELL NO.

4 Rischell "B"

FARM

COMPANY

National Assoc. Petr.

CONTRACTOR

Lincoln

Ritz-Canton Pool

Ft. from N. Line

330


Ft. from S. Line

330

Ft. from E. Line

Ft. from W. Line

SE SE SW

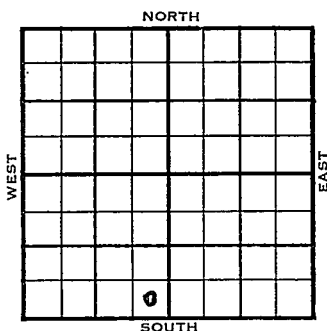

1955

ELEVATION

1539'

REPORT

3/9

Location

4/13

Spud 3-10-55 Oil well TD 2961
8" @ 159 Lans 2315

DST 2320-38 open 1 hr rec 120' SW

650# Miss 2945 TD 2961 5" @ 2950

GO to 2961 B/2 BOCMPH 50 M-A

S/1/2 BOPH 12 hr. frac S/5 BO 1 BWPH

12 hr. Comp. 35 BOPD 20 BW

COMPLETED

County **McPherson** State **Kanazo**

Sec. **27** (Blk. Twp.) **19** (Sur. Rge.) **2W** Map No.

Operator National Assoc. Pet.

Well No. 4 Farm Rischell "B"

Elev.	Location	SE	SE	SW
-------	----------	----	----	----

FIRST REPORT

○

330 Ft. From S Line SW

330 Ft. From E Line Quarter

1st. Report MAR 9 1955

Completion

Remarks

Lincoln - Contr.


Spudding Date

Drlg. Data Ritz-Canton Pool

Location

FABEN GILSTRAP

County McPherson State Kansas
 Sec. 27 (Blk. 19) (Sur. 2W) Map No. 19
 Operator National Assoc. Pet.
 Well No. 4 Farm Rischell "B"
 Elev. 1539 Location SE SE SW

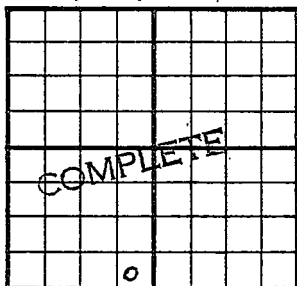

330 Ft. From S Line SW
330 Ft. From E Line Quarter
 Ist. Report
 Completion APR 13 1955
 Remarks Ritz-Canton Pool
Lincoln - Contr.
 Spudding Date 3-10-55

Drlg. Data Oil well TD 2961
8" @ 159 Lans. 2315 DST 2320-38
open 1 hr. Rec. 120' sw 650#
Miss. 2945 TD 2961 5" @ 2950
CO to 2961 B/ 2 bocmph 50 M-A
S/ $\frac{1}{2}$ boph. 12 hr. frac S/ 5 bo 1 bwph
12 hr. Comp. 35 bopd 20 bw

FABEN GILSTRAP