


Section 27 Township 19 S Range 2 W

Well No. # 3 Akerson

Company Geo. Hess

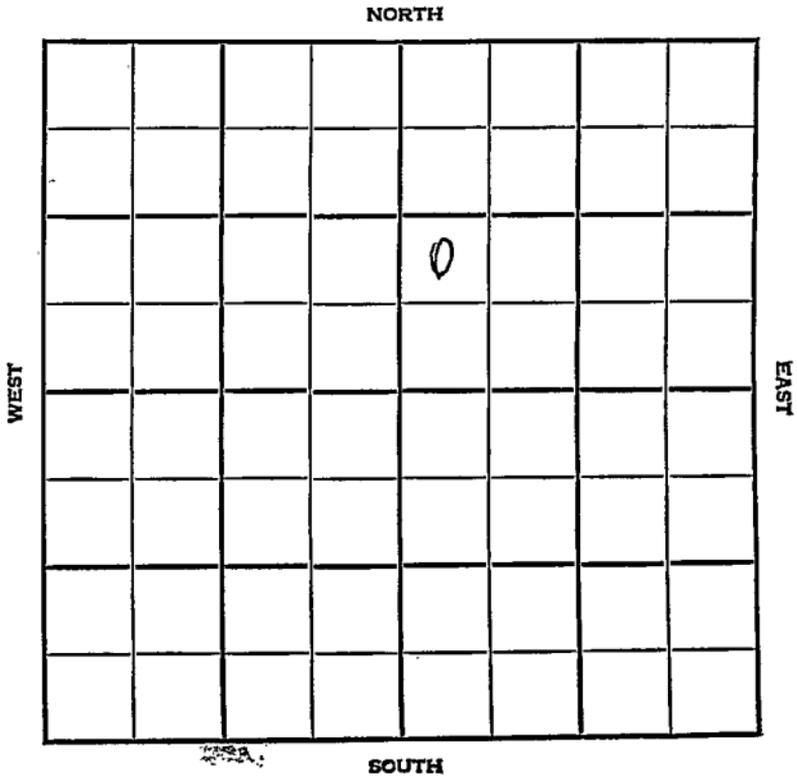

McPherson

KANSAS

SEC: 27	TWP. 19S	R. 2W
------------	-------------	----------


WELL NO. #3 Akerson FARM

COMPANY Geo. Hess

CONTRACTOR Mallard Tools.

Ritz-Canton NORTH

\_\_\_\_\_ Ft. from N. Line  
 990 \_\_\_\_\_ Ft. from S. Line  
 \_\_\_\_\_ Ft. from E. Line  
 330 \_\_\_\_\_ Ft. from W. Line

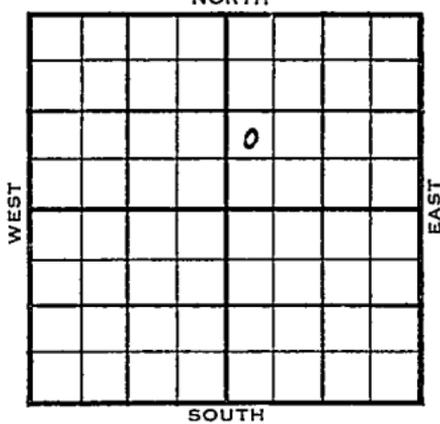

NW SW NE

1954	ELEVATION 1550'	REPORT
------	--------------------	--------

12/8 8" @ 157'  
 WOR.

1955  
 2/9 Spud 12-23-54  
 Oil Well  
 TD 2957'  
 8" @ 157'  
 Miss 2941'  
 TD 2946'  
 5" @ 2943 DD 2957 S/ 1 boph 8 hr.  
 1000 A frac. S/ 2 3/4 boph 8 hr.  
 Comp 32 bopd.

**COMPLETED**

County McPherson State Kansas

Sec. 27 (Blk: 19S) (Sur. Rge.) 2W Map No.

Operator Geo. Hess

Well No. 3 Farm Akerson

Elev. \_\_\_\_\_ Location NW SW NE


**FIRST REPORT**

990 Ft. From S Line

330 Ft. From W Line NE Quarter

Ist. Report DEC 8 1954

Completion \_\_\_\_\_

Remarks Mallard tools

Spudding Date \_\_\_\_\_

Drlg. Data Ritz-Canton

8" @ 157 WOR

